

DEC 09 1993

CHIPPEWA COUNTY REMONUMENTATION CORNER

RECEIVED FOR RECORD
CHIPPEWA COUNTY
STATE OF MICHIGAN

LAND CORNER RECORDATION CERTIFICATE
Filing Requirement of Act 74, Mich. P.A. 1970

93 DEC -3 PM 3: 58

For corners in
Chippewa

(County)	Located In:	Corner Code #
1. Public Land Survey	T47N R 1E T47N R 1W T _____ R _____ T _____ R _____	A-10 Same M-10 Corner
2. Property Controlling in Section	S _____ T _____ R _____ S _____ T _____ R _____	_____
3. Miscellaneous Property in Sec.	S _____ T _____ R _____ *S _____ T _____ R _____	_____
4. Lot No. _____, Recorded Plat _____		
5. Private Claims _____		

J. Roger Mahala
REGISTER OF DEEDS

Register of Deeds Stamp & File Number

I, **Keith R. Waters** in a field survey on **November 1**, 19 **93**, do hereby certify that under requirements of P.A. 74, Michigan P.A. of 1970, the corner points mentioned in lines 1 and 2 above were in conformance with regulations and rules therefore as required in the current manual of survey instructions of the United States Department of the Interior, Bureau of Land Management or by a decree of a Court of Law and/or that the corner points mentioned in lines 3, 4 and 5 above were in conformance with the rules of the Michigan Board of Land Surveyors or by a Decree of a Court of Law; established, re-established, monumented, re-monumented, recovered, found as expressed below:

NOTE: Not more than 4 corners, all in the same town and range, may be recorded on this certificate.

A. Description of original monument and accessories and/or subsequent restoration:

A-10 (T47N, R1E)
1/4 Corner Common to Section 30, T47N, R1E & Section 25, T47N, R1W.

Original ties to set post (Wm. A. Burt, D.S., 1840):

- Tamarack 3, S48°W 24 links
- Tamarack 3, N70°W 48 links

B. Description of corner evidence found and/or method applied in restoring or reestablishing corner:


A-10 (T47N, R1E)
This corner is being re-established as part of the Chippewa County Remonumentation Program.
Found no evidence of corner or its accessories. Re-established corner by single proportionate measurement between established corners at the West 1/4 corner of Section 31, T47N, R1E, and the Northwest corner of Section 30, T47N, R1E. Corner falls on the remains of a north-south fence line and is on the north side of a small clearing containing several white birches, with tag alder swamps north and south of clearing.

C. Description of monument for corner and accessories established to perpetuate locating the position of the corner:

A-10 (T47N, R1E)
Corner is a 3/4" x 48" rebar with a 3 1/4" aluminum Chippewa County Remonumentation cap on the remains of a north-south fence line.

- Witnesses:
- 5" White Birch, N57°E 16.61'
 - 10" White Birch, S10°E 38.27'
 - 5" Black Spruce, SOUTH 36.75'
 - 9" White Birch, WEST 54.71'

Note: Distances are to a nail and tag in the side of witness object. Trees are blazed. Bearings are compass bearings corrected for declination.

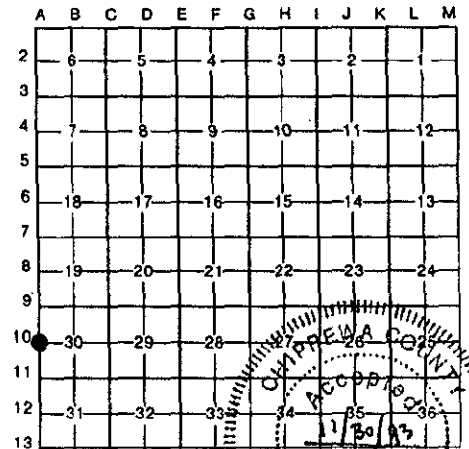

Signed by Keith R. Waters Date 11-30-93

Surveyor's Michigan License No. 33142