

**LAND CORNER RECORDATION CERTIFICATE**  
**Filing Requirement of Act 74, Mich. P.A. 1970**  
 Chippewa County Remonumentation Corner


SECTION  
 For corners in

Chippewa County	Located in:	Corner Code #
1. Public Land Survey	T47N R1E	B-5
	T R	
	T R	
	T R	
2. Property Controlling in Section	S T R	
	S T R	
3. Miscellaneous Property in Sec.	S T R	
	S T R	
4. Lot No. , Recorded Plat		
5. Private Claims		

BOOK **11** PAGE **74**

\$7.00 LAND CORNER  
 \$2.00 NSSR  
 23 FEB 2000 3:39:33 PM Receipt #211  
 RECEIVED FOR RECORD  
 CHIPPEWA COUNTY - STATE OF MICHIGAN  
 SHARON H. KENNEDY, REGISTER OF DEEDS  
 Register of Deeds Stamp & File Number

I, William L. Karr, in a field survey on December 16, 1999, do hereby state that under requirements of P.A. 74, Michigan P.A. of 1970, the corner points mentioned in lines 1 and 2 above were in conformance with regulations and rules therefore as required in the current manual of survey instructions of the United States Department of the Interior, Bureau of Land Management or by a decree of a Court of Law and /or that the corner points mentioned in lines 3, 4 and 5 above were in conformance with the rules of the Michigan Board of Land Surveyors or by a Decree of a Court of Law, established, re-established, monumented, recovered, found as expressed below:

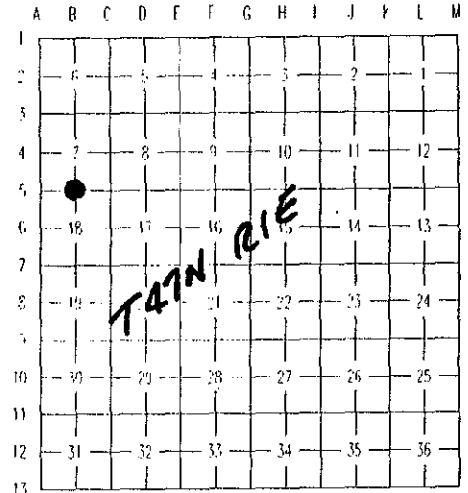


NOTE: Not more than 2 corners, all in the same town and range, may be recorded on this certificate.

A. Description of original monument and accessories and/or subsequent restoration:

(B-5) 1/4 Corner Between Sections 7 and 18, T. 47 N., R. 1 E.

- 1845 James H. Mullett set post in original survey.
- 1887 Guy H. Carleton surveyed Mead and Fowle's Addition, 1/4 corner is the Southeast corner of the plat.
- 1887 Guy H. Carleton surveyed Blank Addition, 1/4 corner is Northwest corner of the plat.
- 1887 Guy H. Carleton surveyed Blank Second Addition, 1/4 corner is Southwest corner of the plat.
- 1887 Guy H. Carleton surveyed Milwaukee Syndicate Addition, 1/4 corner is shown as an iron bolt at the Northeast corner of the plat.
- Early 1900's Numerous notes and sketches in the County Surveyors Office show corner.
- 1940 C.H. Voss, final land ties for M-129 South from the Soo. Notes show the corner as a + stamped in the top of a RR spike 0.35' East of road centerline and distances to the section corners East and West.
- 1950's Harold I. Neff recorded corner in L. 2, P. 247, Chippewa County Corner Records, as a 3/8" copper clad rod in monument box.
- 1976 James H. Granger recorded corner in L. 1, P. 197, Chippewa County Corner Records. Granger shows corner as found monument box set by M.S.H.D.
- 1977 James H. Granger recorded corner in L. 1, P. 248, Chippewa County Corner Records. Granger shows corner as found iron in monument box in road intersection.

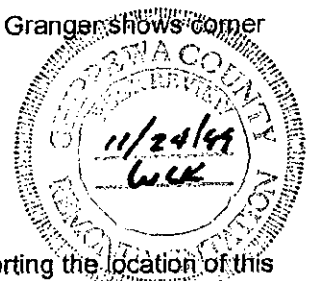

B. Description of corner evidence found and/or method applied in restoring or reestablishing corner:

(B-5) 1/4 Corner Between Sections 7 and 18, T. 47 N., R. 1 E.

This corner is being perpetuated as part of the Chippewa County Remonumentation Program.

Recovered the corner as recorded by Granger in 1977. There is considerable evidence supporting the location of this corner dating back to the plats in the 1880's. In addition to that listed above, there are numerous notes and sketches showing the location of the corner in the early part of the 1900's. Also, there are several recorded certificates of survey using the corner as recorded. Accepted the corner position as found.

C. Description of monument for corner and accessories established to perpetuate locating the position of the corner:

(B-5) 1/4 Corner Between Sections 7 and 18, T. 47 N., R. 1 E.

Corner is a 1/2" iron in a monument box in the approximate centerline of M-129 to the South and 16<sup>th</sup> Ave to the East.

Witnesses	Power Pole	N 36° E	53.35'	Power Pole	S 24° E	70.48'
	"+" in Manhole Rim	S 43° W	74.28'	Wood Sign Post	N 04° W	82.44'

Bearings are compass bearings, corrected for declination (7°), all distances are to a nail and tag in the side of the witness object unless otherwise noted.

Signed by William L. Karr

Date 12-24-99

Surveyor's Michigan License No. 27450

BOOK **11** PAGE **74**

FORM APPROVED BY MICHIGAN STATE BOARD OF PROFESSIONAL SURVEYORS, JAN. 28, 1972  
 REVISED MAY 14, 1976  
 REVISED JAN. 1983  
 REVISED FEB. 2000

