

CHIPPEWA COUNTY REMONUMENTATION CORNER

MAR 27 1996

LAND CORNER RECORDATION CERTIFICATE  
Filing Requirement of Act 74, Mich. P.A. 1970

COMMISSION

For corners in


<u>Chippewa</u> (County)	Located In:	Corner Code #
1. Public Land Survey	T <u>47N</u> R <u>1E</u>	<u>B-9</u>
	T <u>   </u> R <u>   </u>	<u>   </u>
	T <u>   </u> R <u>   </u>	<u>   </u>
	T <u>   </u> R <u>   </u>	<u>   </u>
2. Property Controlling in Section	S <u>   </u> T <u>   </u> R <u>   </u>	<u>   </u>
	S <u>   </u> T <u>   </u> R <u>   </u>	<u>   </u>
3. Miscellaneous Property in Sec.	S <u>   </u> T <u>   </u> R <u>   </u>	<u>   </u>
	S <u>   </u> T <u>   </u> R <u>   </u>	<u>   </u>

\$ 7.00 LAND CORNER  
\$ 2.00 HSSR  
29 FEB 96 9:36 A.M. RECEIPT# 462  
RECEIVED FOR RECORD  
CHIPPEWA COUNTY - STATE OF MICHIGAN  
SHARON H. KENNEDY, REGISTER OF DEEDS

Register of Deeds Stamp & File Number

4. Lot No. \_\_\_\_\_, Recorded Plat \_\_\_\_\_  
5. Private Claims \_\_\_\_\_

I, William L. Karr, in a field survey on Dec. 13, 1995 do hereby state that under requirements of P.A. 74, Michigan P.A. of 1970, the corner points mentioned in lines 1 and 2 above were in conformance with regulations and rules therefore as required in the current manual of survey instructions of the United States Department of the Interior, Bureau of Land Management or by a decree of a Court of Law and /or that the corner points mentioned in lines 3, 4 and 5 above were in conformance with the rules of the Michigan Board of Land Surveyors or by a Decree of a Court of Law; established, re-established, monumented, recovered, found as expressed below:

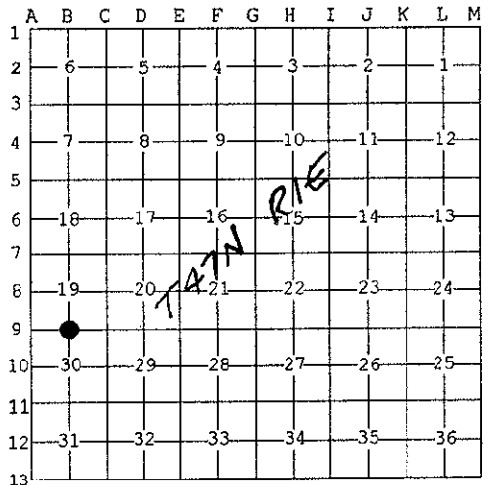

NOTE: Not more than 2 corners, all in the same town and range, may be recorded on this certificate.

A. Description of original monument and accessories and/or subsequent restoration:

(B-9) 1/4 Corner common to Sections 19 and 30, T47N, R1E

- 1845: James H. Mullette set post  
Spruce 5" N37°W 17 links Spruce 5" S35°E 27 links
- 1977: R.H. Larsen set 3/8" iron pipe. Corner was recorded in Liber 2, Page 199.
- 1981: W.L. Karr, P.S. 27450 found 1 1/4" iron pipe consistent with MDOT notes.  
Corner was recorded in Liber 5, Page 150.

B. Description of corner evidence found and/or method applied in restoring or reestablishing corner:

(B-9) This corner is being perpetuated as part of the Chippewa County Remonumentation program.

Found 1 1/4" iron pipe as described in 1981. Accepted corner position as found.



C. Description of monument for corner and accessories established to perpetuate locating the position of the corner:

(B-9) Corner is a 1 1/4" iron pipe in ditch, 15 feet East of East shoulder of M-129.

Witnesses:	Power Pole (63)	N75°E	11.62'
	Power Pole (E20)	S49°E	23.83'
	1/4 Corner 19 & 30	South	5263.32'
	Centerline of M-129	West	38.0' more or less



Signed by William L. Karr  
Surveyor's Michigan License No. 27450

Date 12/15/95

NOTE: Bearings are compass bearings corrected for declination. Distances are to a nail in side of witness objects unless noted.

FORM APPROVED BY MICHIGAN STATE BOARD OF PROFESSIONAL SURVEYORS, JAN. 28, 1971  
REVISED MAY 14, 1975  
REVISED JAN., 1983  
REVISED OCT., 1995