

CHIPPEWA COUNTY REMONUMENTATION CORNER

MAR 27 1996

LAND CORNER RECORDATION CERTIFICATE
Filing Requirement of Act 74, Mich. P.A. 1970

For corners in

COMMISSION

Chippewa Located In: Corner Code #
(County)

1. Public Land Survey T 47N R 1E B-11
T R
T R
T R

2. Property Controlling S T R
in Section S T R

3. Miscellaneous S T R
Property in Sec. S T R

\$ 7.00 LAND CORNER
\$ 2.00 MSSR
29 FEB 96 9:37 A.M. RECEIPT# 462
RECEIVED FOR RECORD
CHIPPEWA COUNTY - STATE OF MICHIGAN
SHARON H. KENNEDY, REGISTER OF DEEDS

Register of Deeds Stamp & File Number

4. Lot No. _____, Recorded Plat _____
5. Private Claims _____

I, William L. Karr, in a field survey on Dec. 8, 1995 do hereby state that under requirements of P.A. 74, Michigan P.A. of 1970, the corner points mentioned in lines 1 and 2 above were in conformance with regulations and rules therefore as required in the current manual of survey instructions of the United States Department of the Interior, Bureau of Land Management or by a decree of a Court of Law and/or that the corner points mentioned in lines 3, 4 and 5 above were in conformance with the rules of the Michigan Board of Land Surveyors or by a Decree of a Court of Law, established, re-established, monumented, recovered, found as expressed below:

A	B	C	D	E	F	G	H	I	J	K	L	M
1												
2	6	5	4	3	2	1						
3												
4	7	8	9	10	11	12						
5												
6	13	17	16	15	14	13						
7												
8	19	20	21	22	23	24						
9												
10	30	29	28	27	26	25						
11	●											
12	31	32	33	34	35	36						
13												

NOTE: Not more than 2 corners, all in the same town and range, may be recorded on this certificate.

A. Description of original monument and accessories and/or subsequent restoration:

(B-11) 1/4 Corner common to Sections 30 and 31, T47N, R1E

1845: James H. Mullette set post

Fir 10" N55°W 13 links Spruce 10" S40°E 9 links

1977: R.H. Larsen set 3/8" pipe. Corner is recorded in Liber 2, Page 196.

1981: W.L. Karr, P.S. 27450 found a 3/4" square bolt in monument box in the centerline of M-129. Corner was recorded in Liber 5, Page 150.

B. Description of corner evidence found and/or method applied in restoring or reestablishing corner:


(B-11) This corner is being perpetuated as part of the Chippewa County Remonumentation program.

Found 3/4" iron in monument box as described in 1981. Accepted corner position as found.

C. Description of monument for corner and accessories established to perpetuate locating the position of the corner:

(B-11) Corner is a 3/4" square bolt in monument box in centerline of M-129.

Witnesses:	Power Pole (DR3/130)	N55°W	89.97' (existing)
	Corner Fence Post	N43°E	71.52'
	NW Corner Concrete Headwall	N54°E	40.79' (existing)
	Stop Sign Post	N65°E	58.18'
	Concrete R.O.W. Monument	S46°E	68.65' (existing)

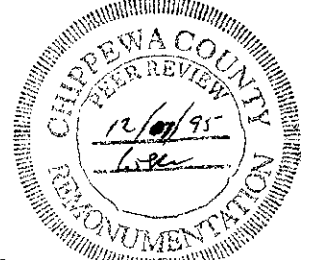

Signed by William L. Karr
Surveyor's Michigan License No. 27450

Date 12/08/95

NOTE: Bearings are compass bearings corrected for declination. Distances are to a nail in side of witness objects unless noted. FORM APPROVED BY MICHIGAN STATE BOARD OF PROFESSIONAL SURVEYORS, JAN. 28, 1971
REVISED MAY 14, 1975
REVISED JAN., 1983
REVISED OCT., 1995