


LAND CORNER RECORDATION CERTIFICATE
Filing Requirement of Act 74, Mich. P.A. 1970
Chippewa County Remonumentation Corner

For corners in SECTION

Chippewa County	Located in:	Corner Code #
1. Public Land Survey	T47N R1E	C-6
	T R	
	T R	
	T R	
2. Property Controlling in Section	S T R	
	S T R	
3. Miscellaneous Property in Sec.	S T R	
	S T R	
4. Lot No.	Recorded Plat	
5. Private Claims		

BOOK **11** PAGE **78**
 \$7.00 LAND CORNER
 \$2.00 NSSR
 23 FEB 2000 3:44:01 PM Receipt #21174
 RECEIVED FOR RECORD
 CHIPPEWA COUNTY - STATE OF MICHIGAN
 SHARON H. KENNEDY, REGISTER OF DEEDS
 Register of Deeds Stamp & File Number

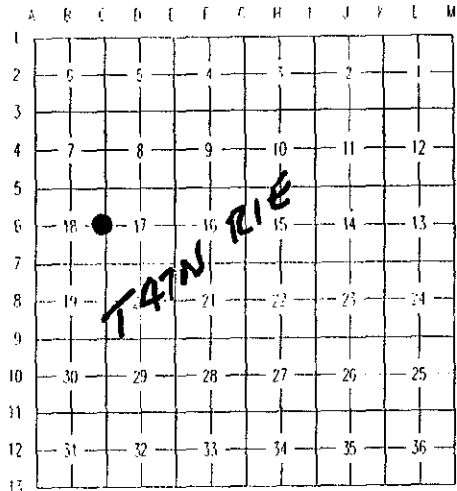

I, William L. Karr, in a field survey on December 13, 1999, do hereby state that under requirements of P.A. 74, Michigan P.A. of 1970, the corner points mentioned in lines 1 and 2 above were in conformance with regulations and rules therefore as required in the current manual of survey instructions of the United States Department of the Interior, Bureau of Land Management or by a decree of a Court of Law and /or that the corner points mentioned in lines 3, 4 and 5 above were in conformance with the rules of the Michigan Board of Land Surveyors or by a Decree of a Court of Law; established, re-established, monumented, recovered, found as expressed below:

NOTE: Not more than 2 corners, all in the same town and range, may be recorded on this certificate.

A. Description of original monument and accessories and/or subsequent restoration:

(C-6) 1/4 Corner Between Sections 17 and 18, T. 47 N., R. 1 E.

- 1845 James H. Mullett set post in original survey.
- Early 1900's F.H. Brown, section drawings in County Surveyor Record Book #1 for sections 17 and 18. Brown's notes do not indicate a monument at the 1/4 corner but show the mile as evenly divided.
- 1984 Larry R. Rogers, P.S. 29251, found no evidence of original corner. Rogers re-established corner at a fence intersection and recorded it in L. 6, P. 318, Chippewa County Corner Records.
- 1994 Keith R. Waters, P.S. 33142, certificate of survey in section 18, project number 94126, shows found corner and ties as recorded by Rogers in 1984.

Description of corner evidence found and/or method applied in restoring or reestablishing corner:

(C-6) 1/4 Corner Between Sections 17 and 18, T. 47 N., R. 1 E.

This corner is being perpetuated as part of the Chippewa County Remonumentation Program.

Recovered no evidence of original corner. Brown's records show 2 distances for the mile, 5154' and 5136', and show the mile as evenly divided but do not indicate a monument being placed at the 1/4 corner. The position recorded by Rogers in 1984 falls 3.3' East of a line between the section corners to the North and South, and measures 2581.5' to the North, and 2572.9 to the South. The fence used to re-establish the corner is very old and pre-dates other development in the area. Accepted the fence as evidence of section subdivision done by Brown in the early 1900's and Rogers re-establishment of the corner position.

Recovered the 1/2" iron placed by Rogers and replaced it with a 3/4" x 48" iron with a stamped aluminum Chippewa County Remonumentation cap.

C. Description of monument for corner and accessories established to perpetuate locating the position of the corner:

(C-6) 1/4 Corner Between Sections 17 and 18, T. 47 N., R. 1 E.

Corner is a 3/4" x 48" iron with a stamped aluminum Chippewa County Remonumentation cap. The corner falls at the base of a hill at fence intersection, fences North and East.

Witnesses:	12" Aspen	N 66° E	25.34'
	8" White Birch	S 61° E	35.22'
	15" Sugar Maple	S 26° W	38.69'
	15" Sugar Maple	N 78° W	33.87'

BOOK **11** PAGE **78**

Bearings are compass bearings, corrected for declination (7° W), all distances are to a nail and tag in the side of the witness object, unless otherwise noted.

Signed by William L. Karr

Date 12-24-99

Surveyor's Michigan License No. 27450

