

CHIPPEWA COUNTY REMONUMENTATION CORNER

MAR 27 1996

LAND CORNER RECORDATION CERTIFICATE
Filing Requirement of Act 74, Mich. P.A. 1970

For corners in COMMISSION

<u>Chippewa</u> (County)	Located In:	Corner Code #
1. Public Land Survey	<u>T47N R1E</u>	<u>C-9</u>
	T ___ R ___	_____
	T ___ R ___	_____
	T ___ R ___	_____
2. Property Controlling in Section	S ___ T ___ R ___	_____
	S ___ T ___ R ___	_____
3. Miscellaneous Property in Sec.	S ___ T ___ R ___	_____
	S ___ T ___ R ___	_____


\$ 7.00 LAND CORNER
\$ 2.00 MSSR
29 FEB 96 9:37 A.M. RECEIPT# 462
RECEIVED FOR RECORD
CHIPPEWA COUNTY - STATE OF MICHIGAN
SHARON H. KENNEDY, REGISTER OF DEEDS

Register of Deeds Stamp & File Number

4. Lot No. _____, Recorded Plat _____
5. Private Claims _____

I, William L. Karr, in a field survey on Dec. 8, 1995 do hereby state that under requirements of P.A. 74, Michigan P.A. of 1970, the corner points mentioned in lines 1 and 2 above were in conformance with regulations and rules therefore as required in the current manual of survey instructions of the United States Department of the Interior, Bureau of Land Management or by a decree of a Court of Law and /or that the corner points mentioned in lines 3, 4 and 5 above were in conformance with the rules of the Michigan Board of Land Surveyors or by a Decree of a Court of Law; established, re-established, monumented, recovered, found as expressed below.

NOTE: Not more than 2 corners, all in the same town and range, may be recorded on this certificate.

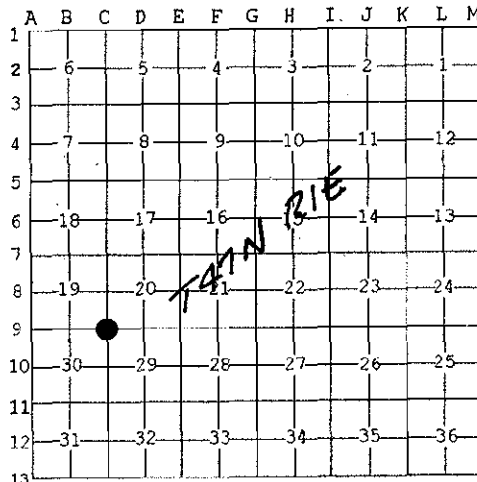

A. Description of original monument and accessories and/or subsequent restoration:

(C-9) Section Corner 19, 20, 29 and 30, T47N, R1E

1845: James H. Mullette set post

B. Ash 8" N58°W 34 links Fir 6" N20°E 7 links


1977: R.H. Larsen set 3/8" pipe . Corner was recorded in Liber 2, Page 200.

1992: W.L. Karr, P.S. 27450 re-established corner at intersection of old fencelines to North and West. Corner was recorded in Liber 8, Page 251.

B. Description of corner evidence found and/or method applied in restoring or reestablishing corner.

(C-9) This corner is being perpetuated as part of the Chippewa County Remonumentation program.

Found 1/2" iron with cap No. 27450 as described in 1992. Accepted corner position as found.

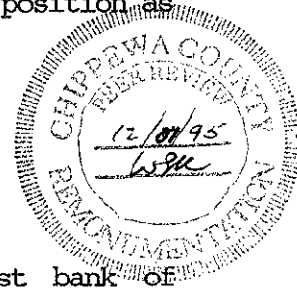

C. Description of monument for corner and accessories established to perpetuate locating the position of the corner:

(C-9) Corner is a 1/2" iron with cap #27450. Falls at top of West bank of North-South drainage ditch on range of old fences to North-West.

Witnesses:	6" Poplar	N19°W	60.41' (existing)
	10" Poplar	N35°W	72.46' (existing)
	3" Ck. Cherry	N63°W	3.78' (existing)
	1/2" iron w/cap No. 27450	South	327.10'



Signed by William L. Karr
Surveyor's Michigan License No. 27450

Date 12/15/95

NOTE: Bearings are compass bearings corrected for declination. Distances are to a nail in side of witness objects unless noted. FORM APPROVED BY MICHIGAN STATE BOARD OF PROFESSIONAL SURVEYORS, JAN. 28, 1971
REVISED MAY 14, 1975
REVISED JAN., 1983
REVISED OCT., 1995