MAR 27 1996

COMMISSION

CHIPPEWA COUNTY REMONUMENTATION CORNER

LAND CORNER RECORDATION CERTIFICATE

Filing Requirement of Act 74, Mich. P.A. 1970

For corners in

Chippewa (County)

	Located In:			Corner Code #
1. Public Land Survey		T47N	R 1E	C-12
		T___	R___	_____
		T___	R___	_____
		T___	R___	_____
2. Property Controlling	S___	T___	R___	_____
in Section	S___	T___	R___	_____
3. Miscellaneous	S___	T___	R___	_____
Property in Sec.	S___	T___	R___	_____

4. Lot No. _____ , Recorded Plat _____

5. Private Claims _____

$ 7.00 LAND CORNER
$ 2.00 MSSR
29 FEB 96 9:38 A.M. RECEIPT# 462
RECEIVED FOR RECORD
CHIPPEWA COUNTY - STATE OF MICHIGAN
SHARON H. KENNEDY, REGISTER OF DEEDS
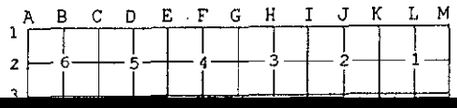
Register of Deeds Stamp & File Number