


LAND CORNER RECORDATION CERTIFICATE
Filing Requirement of Act 74, Mich. P.A. 1970
Chippewa County Remonumentation Corner

For corners in SECTION

Chippewa County	Located in:	Corner Code #
1. Public Land Survey	T47N R1E	D-5
	T R	
	T R	
	T R	
2. Property Controlling in Section	S T R	
	S T R	
3. Miscellaneous Property in Sec.	S T R	
	S T R	
4. Lot No. , Recorded Plat		
5. Private Claims		

BOOK 11 PAGE 80

\$7.00 LAND CORNER
 \$2.00 MSSR
 23 FEB 2000 3:45:46 PM Receipt #21174
 RECEIVED FOR RECORD
 CHIPPEWA COUNTY - STATE OF MICHIGAN
 SHARON H. KENNEDY, REGISTER OF DEEDS
 Register of Deeds Stamp & File Number

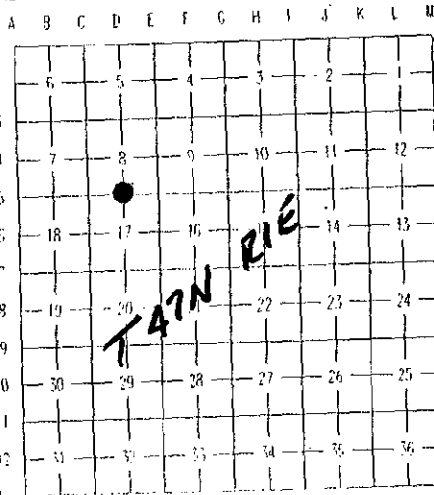

I, William L. Karr, in a field survey on December 15, 1999, do hereby state that under requirements of P.A. 74, Michigan P.A. of 1970, the corner points mentioned in lines 1 and 2 above were in conformance with regulations and rules therefore as required in the current manual of survey instructions of the United States Department of the Interior, Bureau of Land Management or by a decree of a Court of Law and /or that the corner points mentioned in lines 3, 4 and 5 above were in conformance with the rules of the Michigan Board of Land Surveyors or by a Decree of a Court of Law; established, re-established, monumented, recovered, found as expressed below:

NOTE: Not more than 2 corners, all in the same town and range, may be recorded on this certificate.

A. Description of original monument and accessories and/or subsequent restoration:

(D-5) 1/4 Corner Between Sections 8 and 17, T. 47 N., R. 1 E.

- 1845 James H. Mullett set post in original survey.
- 1884 Guy H. Carleton surveyed John McNaughton's Addition, recorded L. 1, P. 1, Chippewa County Plats. Carleton shows the 1/4 corner as the Northeast corner of the plat.
- 1887 Guy H. Carleton surveyed Ainsworth Addition, recorded L. 1, P. 27, Chippewa County Plats. Carleton shows the 1/4 corner as the Southeast corner of the plat.
- 1887 Guy H. Carleton surveyed McGregor Addition, recorded L. 1, P. 35, Chippewa County Plats. Carleton shows the 1/4 corner as the Southwest corner of the plat.
- Early 1900's F.H. Brown, many notes and sketches in County Surveyors Office. Brown notes that he could find no monument for the corner and shows the mile as measuring 5525' and evenly divided.
- 1984 Larry R. Rogers, P.S. 29251, found no evidence of original corner. Rogers found a 1" iron in concrete matching 3 existing subdivisions and recorded corner in L. 6, P. 318, Chippewa County Corner Records.
- 1991 Keith R. Waters, P.S. 33142, Certificate of Survey recorded L. 570, P. 693, Chippewa County Records shows corner as recorded by Rogers in 1984.

B. Description of corner evidence found and/or method applied in restoring or reestablishing corner:

(D-5) 1/4 Corner Between Sections 8 and 17, T. 47 N., R. 1 E.

This corner is being perpetuated as part of the Chippewa County Remonumentation Program.

Recovered 1" iron in concrete recorded by Rogers in 1984 and used by Waters in 1991. The corner falls 10.9' North of a line between the section corners to the East and West and measures 2762.57' to the East and 2763.11' to the West. Accepted the 1" iron in concrete for the corner position.

C. Description of monument for corner and accessories established to perpetuate locating the position of the corner:

(D-5) 1/4 Corner Between Sections 8 and 17, T. 47 N., R. 1 E.

The corner is a 1" iron in a 4" diameter concrete monument. The corner falls along a North-South power line approximately 300' South of 15th Street.

Witnesses:	SW Corner House Foundation	N 14° E	246.54'
	Power Pole H/44/A	S 05° E	178.01'
	Power Pole H/43/A	N 56° W	39.17'
	Power Pole H/43	N 44° W	30.92'

Bearings are compass bearings, corrected for declination (7° W), all distances are to a pk nail in the side of the witness unless otherwise noted.

Signed by William L. Karr

Date 12-29-99

Surveyor's Michigan License No. 27450

