

SURVEY & REMONUMENTATION

DEC 09 1993

COMMISSION

Chippewa County Remonumentation Corner

LAND CORNER RECORDATION CERTIFICATE
Filing Requirement of Act 74, Mich. P.A. 1970

RECEIVED FOR RECORD
CHIPPEWA COUNTY
STATE OF MICHIGAN

93 NOV 31 AM 9:55

J. Roger Malachuk
REGISTER OF DEEDS

For corners in

Chippewa
(County)

Located In:

Corner Code #

- | | | |
|---------------------------------------|--------------------------|-------------|
| 1. Public Land Survey | T <u>47N</u> R <u>1E</u> | <u>D-13</u> |
| | T _____ R _____ | _____ |
| | T _____ R _____ | _____ |
| | T _____ R _____ | _____ |
| 2. Property Controlling In Section | S _____ T _____ R _____ | _____ |
| | S _____ T _____ R _____ | _____ |
| 3. Miscellaneous Property in Sec. | S _____ T _____ R _____ | _____ |
| | S _____ T _____ R _____ | _____ |
| 4. Lot No. _____, Recorded Plat _____ | | |
| 5. Private Claims _____ | | |

Register of Deeds Stamp & File Number

I, William L. Karr, in a field survey on July 29, 19 93, do hereby certify that under requirements of P.A. 74, Michigan P.A. of 1970, the corner points mentioned in lines 1 and 2 above were in conformance with regulations and rules therefore as required in the current manual of survey instructions of the United States Department of the Interior, Bureau of Land Management or by a decree of a Court of Law and/or that the corner points mentioned in lines 3, 4 and 5 above were in conformance with the rules of the Michigan Board of Land Surveyors or by a Decree of a Court of Law; established, re-established, monumented, re-monumented, recovered, found as expressed below:

NOTE: Not more than 4 corners, all in the same town and range, may be recorded on this certificate.

A. Description of original monument and accessories and/or subsequent restoration:

(D-13) South 1/4 Corner Section 32, T47N-R1E

1840 William A. Burt, P.S. set post
6" Spruce N62°W 16 links
4" Hemlock N21°E 22 links

B. Description of corner evidence found and/or method applied in restoring or reestablishing corner:

(D-13) This corner reestablished as part of the Chippewa County Remonumentation Program.



Corner position was established on the extension of a fence line to the North. North-South position was established by splitting right-of-way fences to the North and South.

C. Description of monument for corner and accessories established to perpetuate locating the position of the corner:

(D-13) Corner is a 3/4" x 24" iron with stamped 2 1/2" diameter aluminum cap (Chippewa County Monumentation) P.S. 27450. Corner falls in approximate centerline East-West farm lane on extension of fence to North.

| | | |
|-----------------------------------|-------|--------|
| Witnesses: Wood corner fence post | North | 25.21' |
| 14" Burr Oak | N62°E | 60.32' |
| 10" Twin Maple | S46°E | 40.66' |
| 12" Forked Maple | N40°W | 61.74' |
| North 1/4 Corner Section 5 | West | 23.96' |

| | | | | | | | | | | | | | |
|----|----|----|----|----|----|----|---|---|---|---|---|---|---|
| | A | B | C | D | E | F | G | H | I | J | K | L | M |
| 2 | 6 | 5 | 4 | 3 | 2 | 1 | | | | | | | |
| 3 | | | | | | | | | | | | | |
| 4 | 7 | 8 | 9 | 10 | 11 | 12 | | | | | | | |
| 5 | | | | | | | | | | | | | |
| 6 | 18 | 17 | 16 | 15 | 14 | 13 | | | | | | | |
| 7 | | | | | | | | | | | | | |
| 8 | 19 | 20 | 21 | 22 | 23 | 24 | | | | | | | |
| 9 | | | | | | | | | | | | | |
| 10 | 30 | 29 | 28 | 27 | 26 | 25 | | | | | | | |
| 11 | | | | | | | | | | | | | |
| 12 | 31 | 32 | 33 | 34 | 35 | 36 | | | | | | | |
| 13 | | | | | | | | | | | | | |

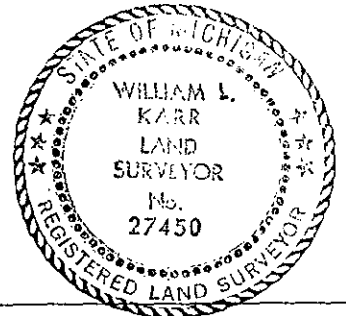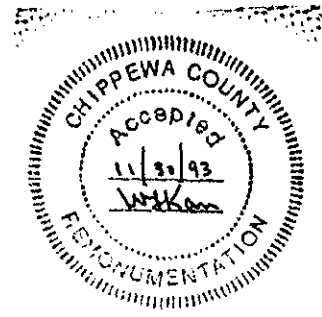

Signed by William L. Karr Date 11/12/93
Surveyor's Michigan License No. 27450

NOTE: Bearings are compass bearings corrected for declination.
Distances are to a nail in side of witness objects unless noted.