

**LAND CORNER RECORDATION CERTIFICATE**  
**Filing Requirement of Act 74, Mich. P.A. 1970**  
**Chippewa County Remonumentation Corner**


For corners in SECTION

BOOK 11 PAGE 81

Chippewa County	Located in:	Corner Code #
1. Public Land Survey	T47N R1E	E-4
	T R	
	T R	
	T R	
2. Property Controlling in Section	S T R	
	S T R	
3. Miscellaneous Property in Sec.	S T R	
	S T R	
4. Lot No. , Recorded Plat		
5. Private Claims		

\$7.00 LAND CORNER  
 \$2.00 MSSR  
 23 FEB 2000 3:46:34 PM Receipt #21174  
 RECEIVED FOR RECORD  
 CHIPPEWA COUNTY - STATE OF MICHIGAN  
 SHARON H. KENNEDY, REGISTER OF DEEDS

Register of Deeds Stamp & File Number

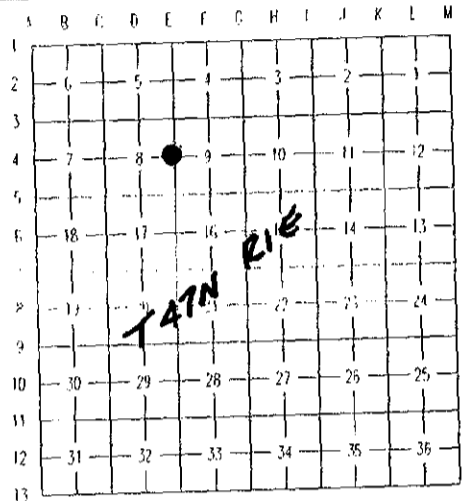

I, William L. Karr, in a field survey on December 13, 1999, do hereby state that under requirements of P.A. 74, Michigan P.A. of 1970, the corner points mentioned in lines 1 and 2 above were in conformance with regulations and rules therefore as required in the current manual of survey instructions of the United States Department of the Interior, Bureau of Land Management or by a decree of a Court of Law and /or that the corner points mentioned in lines 3, 4 and 5 above were in conformance with the rules of the Michigan Board of Land Surveyors or by a Decree of a Court of Law; established, re-established, monumented, recovered, found as expressed below:

NOTE: Not more than 2 corners, all in the same town and range, may be recorded on this certificate.

A. Description of original monument and accessories and/or subsequent restoration:

(E-4) 1/4 Corner Between Sections 8 and 9, T. 47 N., R. 1 E.

- 1845 James H. Mullett set post in original survey.
- 1887 Guy H. Carleton surveyed A.B. Wilgus Addition. Carleton shows the 1/4 corner as the Northeast corner of the plat.
- 1901 F.H. Brown surveyed E.G. Endress Subdivision. Brown shows the 1/4 corner to be the Southwest corner of the subdivision and monumented with a 3/4" x 30" iron bolt.
- 1902 F.H. Brown surveyed Plat of Martyn and Stuart's Addition. Brown shows the 1/4 corner to be the Northwest corner of the plat and monumented with a 5/8" x 30" iron bolt.
- Early 1900's An undated sketch of section 8 in the County Surveyors Office shows the distance from the 1/4 corner South to the section corner as 2633.4'.
- 1986 William L. Karr, P.S. 27450, recorded corner in L. 6, P. 369, Chippewa County Corner Records, Recovered a 3/4" iron in Shunk Road whose position worked well with corners in A.B. Wilgus Addition.

B. Description of corner evidence found and/or method applied in restoring or reestablishing corner:

(E-4) 1/4 Corner Between Sections 8 and 9, T. 47 N., R. 1 E.

This corner is being perpetuated as part of the Chippewa County Remonumentation Program.

Found no evidence of the original corner. Recovered the 3/4" iron as recorded in 1986, the distance to the section corner to the South measures 2623.31'. Accepted the 3/4" iron for the corner and set an aluminum Chippewa County Remonumentation cap on the iron and placed a monument box around the corner.

C. Description of monument for corner and accessories established to perpetuate locating the position of the corner:

(E-4) 1/4 Corner Between Sections 8 and 9, T. 47 N., R. 1 E.

The corner is a 3/4" iron with a stamped Chippewa County Remonumentation Cap in a monument box. The corner falls 1.5' West of the centerline Shunk Road and on the centerline 8<sup>th</sup> Ave. to the East.

Witnesses:	Power Pole #G27/1	N 14° E	154.72' (existing)
	Power Pole #F27/1	S 57° E	40.17' (existing)
	Hydrant (top nut)	S 44° E	43.87' (existing)
	Power Pole	S 53° W	30.72' (existing)


BOOK 11 PAGE 81

Bearings are compass bearings, corrected for declination (7° W), all distances are to a nail and tag in the side of the witness object unless otherwise noted.

Signed by William L. Karr

Date 12-29-99

Surveyor's Michigan License No. 27450

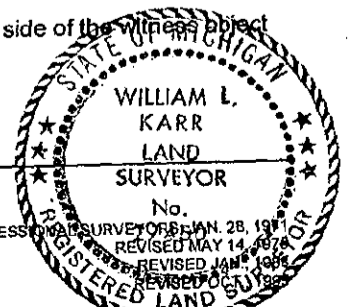

FORM APPROVED BY MICHIGAN STATE BOARD OF PROFESSIONAL SURVEYORS JAN. 28, 1971  
 REVISED MAY 14, 1978  
 REVISED JAN. 1986  
 REVISED OCT. 1988