


LAND CORNER RECORDATION CERTIFICATE
Filing Requirement of Act 74, Mich. P.A. 1970
 Chippewa County Remonumentation Corner

For corners in SECTION

| | | |
|------------------------------------|-------------|---------------|
| Chippewa County | Located in: | Corner Code # |
| 1. Public Land Survey | T47N R1E | E-6 |
| | T R | |
| | T R | |
| | T R | |
| 2. Property Controlling in Section | S T R | |
| | S T R | |
| 3. Miscellaneous Property in Sec. | S T R | |
| | S T R | |
| 4. Lot No. , Recorded Plat | | |
| 5. Private Claims | | |

BOOK **11** PAGE **83**

\$7.00 LAND CORNER
 \$2.00 MSSR
 23 FEB 2000 3:48:22 PM Receipt #2117
 RECEIVED FOR RECORD
 CHIPPEWA COUNTY - STATE OF MICHIGAN
 SHARON H. KENNEDY, REGISTER OF DEEDS
 Register of Deeds Stamp & File Number

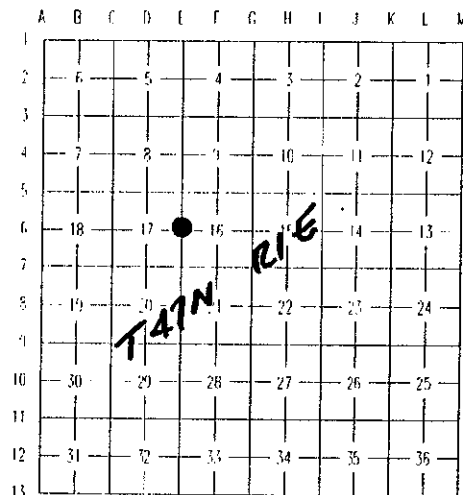

I, William L. Karr, in a field survey on December 13, 1999, do hereby state that under requirements of P.A. 74, Michigan P.A. of 1970, the corner points mentioned in lines 1 and 2 above were in conformance with regulations and rules therefore as required in the current manual of survey instructions of the United States Department of the Interior, Bureau of Land Management or by a decree of a Court of Law and /or that the corner points mentioned in lines 3, 4 and 5 above were in conformance with the rules of the Michigan Board of Land Surveyors or by a Decree of a Court of Law; established, re-established, monumented, recovered, found as expressed below:

NOTE: Not more than 2 corners, all in the same town and range, may be recorded on this certificate.

A. Description of original monument and accessories and/or subsequent restoration:

(E-6) 1/4 Corner between Sections 16 and 17, Township 47 North, Range 1 East.

1845 James H. Mullett set post in original survey.

Early 1900's The section survey by F.H. Brown (County Surveyor's Record Book #1, page 174) indicates that the 1/4 corner position is mid-way between the section corners, and on a straight line. Length of line 17/16 is shown to be 5270 feet.

1935 The notes in field book Black-67 indicates that a 3" Cedar post was set as the 1/4 post.

1979 James H. Granger, P.S. 16041, Certificate of Survey in Section 16, Granger Engineering job SSU-1150-00. Survey identifies corner as a found 3/4" iron midway between section corners. Recorded in liber 470, page 155.

1986 Earl S. Strater, P.S. 28424, Certificate of Survey in Section 16, Chippewa job 85-334S. Survey identifies corner as 1/2" iron with 28424 cap. Recorded Liber 741, page 577.

1988 William L. Karr, P.S. 27450, Northwoods Land Surveying job 178-10. Survey shows corner and witnesses as same recorded in Liber 471, page 577.

1996 Recovered corner recorded by Strater. Position falls 3 feet East and midway between Section corners. Subsequent to road re-construction replaced corner with a 1/2" iron with cap no. 27450 in monument box.

B. Description of corner evidence found and/or method applied in restoring or reestablishing corner:

(E-6) 1/4 Corner between Sections 16 and 17, Township 47 North, Range 1 East.

This corner is being perpetuated as part of the Chippewa County Remonumentation Program.

Found no evidence of original corner. Found a 1/2" iron with cap no. 27450 in monument box in the centerline of Shunk Road. Distance North to Section corner is 0.2 feet greater than distance South to Section corner. Accepted corner position as set by Strater.

C. Description of monument for corner and accessories established to perpetuate locating the position of the corner:

(E-6) 1/4 Corner between Sections 16 and 17, Township 47 North, Range 1 East.

Corner is a 1/2" iron with cap no. 27450 in a monument box in the centerline of Shunk Road.

Witnesses:

| | | |
|-------------------|-------|-------------|
| Power Pole #62 | N20°E | 117.34 feet |
| Power Pole #K27/1 | S44°E | 38.68 feet |
| 16" White Pine | S28°W | 93.49 feet |
| 9" Cedar | S72°W | 50.22 feet |
| Top Nut hydrant | N52°W | 27.91 feet |

Bearings are compass bearings, corrected for declination (7°W), all distances are to a nail and tag in the side of the witness object unless otherwise noted.

Signed by William L. Karr

Date 12-24-99

Surveyor's Michigan License No. 27450

