

CHIPPEWA COUNTY REMONUMENTATION CORNER

MAR 27 1996

LAND CORNER RECORDATION CERTIFICATE
Filing Requirement of Act 74, Mich. P.A. 1970

COMMISSION

For corners in


<u>Chippewa</u> (County)	Located In:	Corner Code #
1. Public Land Survey	T <u>47N</u> R <u>1E</u>	<u>E-8</u>
	T <u> </u> R <u> </u>	<u> </u>
	T <u> </u> R <u> </u>	<u> </u>
	T <u> </u> R <u> </u>	<u> </u>
2. Property Controlling in Section	S <u> </u> T <u> </u> R <u> </u>	<u> </u>
	S <u> </u> T <u> </u> R <u> </u>	<u> </u>
3. Miscellaneous Property in Sec.	S <u> </u> T <u> </u> R <u> </u>	<u> </u>
	S <u> </u> T <u> </u> R <u> </u>	<u> </u>

\$ 7.00 LAND CORNER
\$ 2.00 HSSR
29 FEB 96 9:39 A.M. RECEIPT# 462
RECEIVED FOR RECORD
CHIPPEWA COUNTY - STATE OF MICHIGAN
SHARON H. KENNEDY, REGISTER OF DEEDS

Register of Deeds Stamp & File Number

4. Lot No. _____, Recorded Plat _____
5. Private Claims _____

I, William L. Karr, in a field survey on Dec. 13, 1995 do hereby state that under requirements of P.A. 74, Michigan P.A. of 1970, the corner points mentioned in lines 1 and 2 above were in conformance with regulations and rules therefore as required in the current manual of survey instructions of the United States Department of the Interior, Bureau of Land Management or by a decree of a Court of Law and/or that the corner points mentioned in lines 3, 4 and 5 above were in conformance with the rules of the Michigan Board of Land Surveyors or by a Decree of a Court of Law; established, re-established, monumented, recovered, found as expressed below:

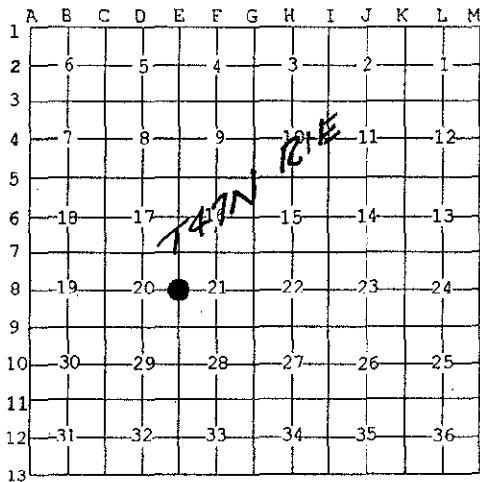

NOTE: Not more than 2 corners, all in the same town and range, may be recorded on this certificate.

A. Description of original monument and accessories and/or subsequent restoration:

- (E-8) 1/4 Corner common to Sections 20 and 21, T47N, R1E
- 1845: James H. Mullette set post
Fir 10" N22°E 16 links Fir 10" S35°W 25 links
- 1976: N.D. Alix, P.S. 6254 re-established corner by single proportionate measurement.
Corner was recorded in Liber 1, Page 211.
- 1987: W.L. Karr, P.S. 27450 re-established 1/4 corner on line between Section corners to the North and South and on extension of old fenceline to the West. Corner falls 9.36' South of corner recorded in Liber 1, Page 211. New position was recorded in Liber 6, Page 400.

B. Description of corner evidence found and/or method applied in restoring or reestablishing corner:


(E-8) This corner is being perpetuated as part of the Chippewa County Remonumentation program.

Found both corners previously recorded. Corner recorded in 1976 ignored 1/4 line fences East and West of the road. Corner re-established in 1987 better represents 1/4 corner position based on old fences in Sections 20 and 21. Accepted corner position established in 1987.

C. Description of monument for corner and accessories established to perpetuate locating the position of the corner:

(E-8) Corner is a 1/2" iron 5" below pavement. Corner falls 3.7 feet West of centerline of Shunk Road.

Witnesses:	Power Pole (DR3/188)	N36°E	112.25' (existing)
	Power Pole (DR3/187)	S23°E	132.70' (existing)
	6" Spruce	N86°W	48.79'
	NE Garage Corner	N56°W	103.00' (existing)
	1/2" iron	North	9.36'

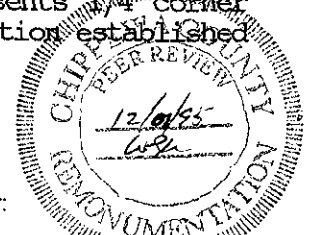

Signed by William L. Karr
Surveyor's Michigan License No. 27450

Date 12/15/95

NOTE: Bearings are compass bearings corrected for declination. Distances are to a nail in side of witness objects unless noted. FORM APPROVED BY MICHIGAN STATE BOARD OF PROFESSIONAL SURVEYORS, JAN. 28, 1971
REVISED MAY 14, 1975
REVISED JAN., 1983
REVISED OCT., 1985