

DEC 09 1993

CHIPPEWA COUNTY REMONUMENTATION CORNER

RECEIVED FOR RECORD
CHIPPEWA COUNTY
STATE OF MICHIGAN

COMMISSION

LAND CORNER RECORDATION CERTIFICATE
Filing Requirement of Act 74, Mich. P.A. 1970

93 DEC -3 PM 3:57

For corners in
Chippewa


(County)	Located In:	Corner Code ##
1. Public Land Survey	T <u>47N</u> R <u>1E</u>	<u>G-7</u>
	T _____ R _____	_____
	T _____ R _____	_____
	T _____ R _____	_____
2. Property Controlling in Section	S _____ T _____ R _____	_____
	S _____ T _____ R _____	_____
3. Miscellaneous Property in Sec.	S _____ T _____ R _____	_____
	S _____ T _____ R _____	_____

J. Roger Matlock
REGISTER OF DEEDS

Register of Deeds Stamp & File Number

4. Lot No. _____, Recorded Plat _____
5. Private Claims _____

I, Keith R. Waters in a field survey on June 9, 1993, do hereby certify that under requirements of P.A. 74, Michigan P.A. of 1970, the corner points mentioned in lines 1 and 2 above were in conformance with regulations and rules therefore as required in the current manual of survey instructions of the United States Department of the Interior, Bureau of Land Management or by a decree of a Court of Law and/or that the corner points mentioned in lines 3, 4 and 5 above were in conformance with the rules of the Michigan Board of Land Surveyors or by a Decree of a Court of Law, established, re-established, monumented, re-monumented, recovered, found as expressed below:

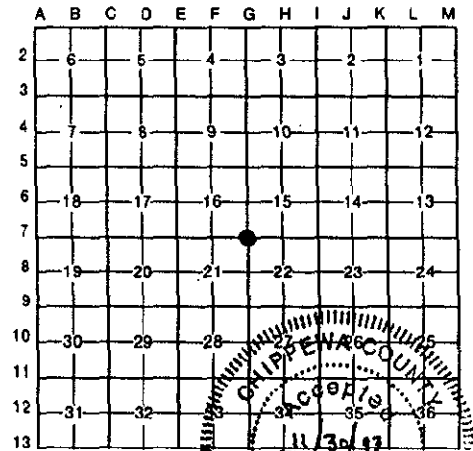

NOTE: Not more than 4 corners, all in the same town and range, may be recorded on this certificate.

A. Description of original monument and accessories and/or subsequent restoration:

G-7 Section Corner Common to Sections 15, 16, 21, & 22, T47N, R1E
This corner is recorded in liber 1, page 212, of Chippewa County corner records (1976), by Neree D. Alix, R.L.S. 6254, as a 1/2" capped rered, position established by a court case in the 1890's, with the following ties:
Right-of-Way Marker, S35°W 55.20'
Stop Sign, N79°E 59.70'
Stop Sign, S39°E 57.55'
Stop Sign, N10°W 24.75'

B. Description of corner evidence found and/or method applied in restoring or reestablishing corner:

G-7 (T47N, R1E)
This corner is being perpetuated as part of the Chippewa County Remonumentation Program.
Found a 1" iron pin in a monument box approximately 17 feet west of centerline of north-south asphalt road (Ridge Road), and approximately 10 feet north of east-west asphalt road (3 Mile Road). Distance to lone remaining witness from previous recording (right-of-way marker) checks very well. Accepted corner as found and established new witness objects.

C. Description of monument for corner and accessories established to perpetuate locating the position of the corner:

G-7 (T47N, R1E)
Corner is a 1" iron pin in a monument box 17 feet west of the centerline of Ridge Road, 10 feet north of the centerline of 3 Mile Road. Witnesses:

- Power Pole (L-31-1), N20°E 115.94'
- 14" Aspen, S65°E 155.49'
- Power Pole, S36°W 53.54'
- Center Top of Concrete R.O.W. Marker, S40°W 55.20'
- Power Pole, N12°W 94.18'

Note: Unless noted otherwise, distances are to a nail and tag in the side of witness object. Bearings are compass bearings corrected for declination. Aspen is blazed and painted. Distances measured with EDM.



Signed by Keith R. Waters Date 11-30-93
Surveyor's Michigan License No. 33142