

CHIPPewa COUNTY REMONUMENTATION CORNER

MAR 27 1996

LAND CORNER RECORDATION CERTIFICATE
Filing Requirement of Act 74, Mich. P.A. 1970

COMMISSION

For corners in


<u>Chippewa</u> (County)	Located In:	Corner Code #
1. Public Land Survey	T <u>47N</u> R <u>1E</u>	<u>G-8</u>
	T ___ R ___	___
	T ___ R ___	___
	T ___ R ___	___
2. Property Controlling in Section	S ___ T ___ R ___	___
	S ___ T ___ R ___	___
3. Miscellaneous Property in Sec.	S ___ T ___ R ___	___
	S ___ T ___ R ___	___

\$ 7.00 LAND CORNER
\$ 2.00 MSSR
29 FEB 96 9:41 A.M. RECEIPT# 462
RECEIVED FOR RECORD
CHIPPewa COUNTY - STATE OF MICHIGAN
SHARON H. KENNEDY, REGISTER OF DEEDS

Register of Deeds Stamp & File Number

4. Lot No. _____, Recorded Plat _____
5. Private Claims _____

I, William L. Karr, in a field survey on Dec. 8, 1995 do hereby state that under requirements of P.A. 74, Michigan P.A. of 1970, the corner points mentioned in lines 1 and 2 above were in conformance with regulations and rules therefore as required in the current manual of survey instructions of the United States Department of the Interior, Bureau of Land Management or by a decree of a Court of Law and /or that the corner points mentioned in lines 3, 4 and 5 above were in conformance with the rules of the Michigan Board of Land Surveyors or by a Decree of a Court of Law; established, re-established, monumented, recovered, found as expressed below:

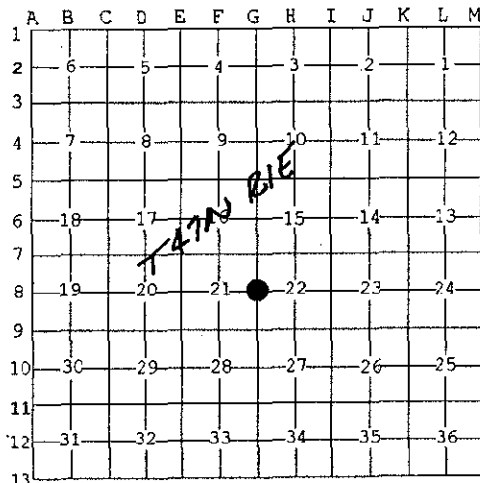

NOTE: Not more than 2 corners, all in the same town and range, may be recorded on this certificate.

A. Description of original monument and accessories and/or subsequent restoration:

(G-8) 1/4 Corner common to Sections 21 and 22, T47N, R1E
1845: James H. Mullette set post
Witnesses: Birch 12" N88°E 33 links
Maple 14" N80°W 13 links

1976: N.D. Alix, P.S. 6254 found no evidence of original corner. Re-established corner using single pro-portionate measurement. Corner was recorded in Liber 1, Page 213.

B. Description of corner evidence found and/or method applied in restoring or reestablishing corner:

(G-8) This corner is being perpetuated as part of the Chippewa County Remonumentation program.
Alix corner was destroyed in road construction. Re-established corner from existing control traverse in previous location by Alix.

C. Description of monument for corner and accessories established to perpetuate locating the position of the corner:

(G-8) Corner is a 3/4" x 15" iron with a plastic "Chippewa County Remonumentation" cap and falls, 4 feet East of Centerline of Ridge Road. Corner also falls 31 feet North of extension of fence line to West.

Witnesses: 10" Aspen S31°E 44.56'
Power Pole S03°W 265.08'
12" Spruce N87°W 40.07'
10" Spruce N17°W 150.59'



Signed by William L. Karr
Surveyor's Michigan License No. 27450

Date 12/15/95

NOTE: Bearings are compass bearings corrected for declination. Distances are to a nail in side of witness objects unless noted. FORM APPROVED BY MICHIGAN STATE BOARD OF PROFESSIONAL SURVEYORS, JAN. 28, 1971
REVISED MAY 14, 1975
REVISED JAN., 1983
REVISED OCT., 1995