

CHIPPEWA COUNTY REMONUMENTATION CORNER

MAR 27 1996

COMMISSION LAND CORNER RECORDATION CERTIFICATE
Filing Requirement of Act 74, Mich. P.A. 1970

For corners in

<u>Chippewa</u> (County)	Located In:	Corner Code #
1. Public Land Survey	T <u>47N</u> R <u>1E</u>	<u>H-11</u>
	T <u> </u> R <u> </u>	<u> </u>
	T <u> </u> R <u> </u>	<u> </u>
	T <u> </u> R <u> </u>	<u> </u>
2. Property Controlling In Section	S <u> </u> T <u> </u> R <u> </u>	<u> </u>
	S <u> </u> T <u> </u> R <u> </u>	<u> </u>
3. Miscellaneous Property in Sec.	S <u> </u> T <u> </u> R <u> </u>	<u> </u>
	S <u> </u> T <u> </u> R <u> </u>	<u> </u>

\$ 7.00 LAND CORNER
\$ 2.00 MSSR
29 FEB 96 9:43 A.M. RECEIPT# 462
RECEIVED FOR RECORD
CHIPPEWA COUNTY - STATE OF MICHIGAN
SHARON H. KENNEDY, REGISTER OF DEEDS

Register of Deeds Stamp & File Number

4. Lot No. _____, Recorded Plat _____
5. Private Claims _____

I, William L. Karr, in a field survey on Dec. 8, 1995 do hereby state that under requirements of P.A. 74, Michigan P.A. of 1970, the corner points mentioned in lines 1 and 2 above were in conformance with regulations and rules therefore as required in the current manual of survey instructions of the United States Department of the Interior, Bureau of Land Management or by a decree of a Court of Law and/or that the corner points mentioned in lines 3, 4 and 5 above were in conformance with the rules of the Michigan Board of Land Surveyors or by a Decree of a Court of Law; established, re-established, monumented, recovered, found as expressed below:

A	B	C	D	E	F	G	H	I	J	K	L	M
1												
2	6		5		4		3		2		1	
3												
4	7		8		9		10		11		12	
5												
6	18		17		16		15		14		13	
7												
8	19		20		21		22		23		24	
9												
10	30		29		28		27		26		25	
11												
12	31		32		33		34		35		36	
13												


NOTE: Not more than 2 corners, all in the same town and range, may be recorded on this certificate.

A. Description of original monument and accessories and/or subsequent restoration:
(H-11) 1/4 Corner common to Sections 27 and 34, T47N, R1E
1845: James H. Mullette set post
Witnesses: Spruce 8" N53°W 27 links
Spruce 4" S35°W 20 links

1987: L.R. Rogers, P.S. 29251 found a 1/2" iron 2 feet below grade and set a 3/4" x 18" iron at road surface. Corner was recorded in Liber 6, Page 364.

B. Description of corner evidence found and/or method applied in restoring or reestablishing corner:
(H-11) This corner is being perpetuated as part of the Chippewa County Remonumentation program.

Found a 3/4" iron and (2) witnesses as described in 1987. Accepted corner position as found and added witnesses.

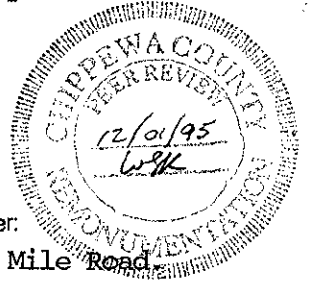

C. Description of monument for corner and accessories established to perpetuate locating the position of the corner:
(H-11) Corner is a 3/4" iron 6" below grade and falls in centerline of 5 Mile Road.

Witnesses: Corner Fence Post N02°E 33.42' (existing)
Power Pole S76°E 199.33'
Fence Post S02°W 33.16'
Power Pole S73°W 112.42' (existing)



Signed by William L. Karr
Surveyor's Michigan License No. 27450

Date 12/15/95

NOTE: Bearings are compass bearings corrected for declination. Distances are to a nail in side of witness objects unless noted.
FORM APPROVED BY MICHIGAN STATE BOARD OF PROFESSIONAL SURVEYORS, JAN. 28, 1971
REVISED MAY 14, 1975
REVISED JAN., 1983
REVISED OCT., 1985