

SURVEY & REMONUMENTATION

RECEIVED FOR RECORD
CHIPPewa COUNTY
STATE OF MICHIGAN

Chippewa County Remonumentation Corner

MAR 09 1994

LAND CORNER RECORDATION CERTIFICATE 93 DEC 29 AM 10:26

Filing Requirement of Act 74, Mich. P.A. 1970

For corners in **COMMISSION**

Chippewa
(County)

Located In:


Corner Code #:

J. Roger Mallick
REGISTER OF DEEDS

- | | | |
|---------------------------------------|--------------------------|------------|
| 1. Public Land Survey | T <u>47N</u> R <u>1E</u> | <u>I-9</u> |
| | T _____ R _____ | _____ |
| | T _____ R _____ | _____ |
| | T _____ R _____ | _____ |
| 2. Property Controlling in Section | S _____ T _____ R _____ | _____ |
| | S _____ T _____ R _____ | _____ |
| 3. Miscellaneous Property in Sec. | S _____ T _____ R _____ | _____ |
| | S _____ T _____ R _____ | _____ |
| 4. Lot No. _____, Recorded Plat _____ | | |
| 5. Private Claims _____ | | |

Register of Deeds Stamp & File Number

I, Larry R. Rogers, in a field survey on November 10, 19 93, do hereby certify that under requirements of P.A. 74, Michigan P.A. of 1970, the corner points mentioned in lines 1 and 2 above were in conformance with regulations and rules therefore as required in the current manual of survey instructions of the United States Department of the Interior, Bureau of Land Management or by a decree of a Court of Law and/or that the corner points mentioned in lines 3, 4 and 5 above were in conformance with the rules of the Michigan Board of Land Surveyors or by a Decree of a Court of Law; established, re-established, monumented, re-monumented, recovered, found as expressed below:

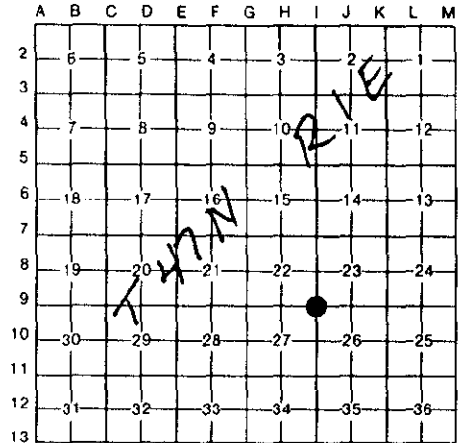

NOTE: Not more than 4 corners, all in the same town and range, may be recorded on this certificate.

A. Description of original monument and accessories and/or subsequent restoration:

(I-9) Section Corner Common to Sections 22, 23, 26 & 27, T47N-R1E

This corner was previously recorded in 1975 by J.H. Granger in Liber 1, Page 176 of the Chippewa County Corner Records as a 1/2" iron bar. Corner was also recorded in 1976 by N.D. Alix in Liber 1, Page 201 as a 1/2" iron rod. Corner is the Point of Beginning of W.J. Sweeney Plat of the St. Mary's River as recorded in Liber 5 of Plats, Page 13.

B. Description of corner evidence found and/or method applied in restoring or reestablishing corner:


(I-9) This corner is being perpetuated as part of the Chippewa County Remonumentation Program.

Corner was removed by the Chippewa County Road Commission during reconstruction of Riverside Drive and replaced with an empty monument box. Position was reestablished by a combination of record witnesses and monumentation in W.J. Sweeney Subdivision.

C. Description of monument for corner and accessories established to perpetuate locating the position of the corner:

(I-9) Corner is a 1/2" x 24" iron with L.S. Cap 27450 in a monument box. Corner is on the centerline of 4 Mile Road and 0.5 feet West of the centerline of Riverside Drive.

Witnesses: Utility Pole (104/E37)	S63°W	51.69'
Utility Pole (104/E36)	N50°W	37.13'
Utility Pole (E503)	N83°E	128.54'
3' high concrete right-of-way monument	S36°E	42.04'

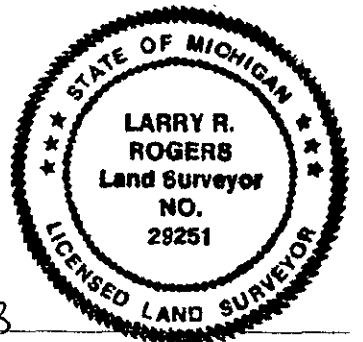

Signed by *[Signature]*

Date 12 Nov 1993

Surveyor's Michigan License No. 29251

NOTE: Bearings are compass bearings corrected for declination. Distances are to a nail in side of witness objects unless noted.