

SURVEY & REMONUMENTATION Chippewa County Remonumentation Corner

RECEIVED FOR RECORD  
CHIPPEWA COUNTY  
STATE OF MICHIGAN

LAND CORNER RECORDATION CERTIFICATE  
Filing Requirement of Act 74, Mich. P.A. 1970

93 DEC 29 AM 10: 26

MAR 09 1994

For corners in

Chippewa COMMISSION  
(County)

Located In:

Corner Code #

- |                                    |                                  |                 |
|------------------------------------|----------------------------------|-----------------|
| 1. Public Land Survey              | T <del>47N</del> R <del>1E</del> | <del>I-10</del> |
|                                    | T _____ R _____                  | _____           |
|                                    | T _____ R _____                  | _____           |
|                                    | T _____ R _____                  | _____           |
| 2. Property Controlling in Section | S _____ T _____ R _____          | _____           |
|                                    | S _____ T _____ R _____          | _____           |
| 3. Miscellaneous Property in Sec.  | S _____ T _____ R _____          | _____           |
|                                    | S _____ T _____ R _____          | _____           |

*J. Roger Malott*  
REGISTER OF DEEDS

Register of Deeds Stamp & File Number

4. Lot No. \_\_\_\_\_, Recorded Plat \_\_\_\_\_  
5. Private Claims \_\_\_\_\_

	A	B	C	D	E	F	G	H	I	J	K	L	M
2	6		5		4		3		2		1		
3													
4	7		8		9		10		11		12		
5													
6	18		17		16		15		14		13		
7													
8	19		20		21		22		23		24		
9													
10	30		29		28		27		26		25		
11													
12	31		32		33		34		35		36		
13													

I, Larry R. Rogers, in a field survey on November 10, 19 93, do hereby certify that under requirements of P.A. 74, Michigan P.A. of 1970, the corner points mentioned in lines 1 and 2 above were in conformance with regulations and rules therefore as required in the current manual of survey instructions of the United States Department of the Interior, Bureau of Land Management or by a decree of a Court of Law and/or that the corner points mentioned in lines 3, 4 and 5 above were in conformance with the rules of the Michigan Board of Land Surveyors or by a Decree of a Court of Law; established, re-established, monumented, re-monumented, recovered, found as expressed below:


NOTE: Not more than 4 corners, all in the same town and range, may be recorded on this certificate.

A. Description of original monument and accessories and/or subsequent restoration:  
(I-10) 1/4 Corner Common to Sections 26 & 27, T47N-R1E

Corner was reestablished in 1976 by J.H. Granger and recorded in Liber 1, Page 196 of the Chippewa County Corner Records as a 1/2" iron. Corner was re-recorded in 1977 by T.M. Kelly in Liber 1, Page 270 as a 1/2" iron.


B. Description of corner evidence found and/or method applied in restoring or reestablishing corner:  
(I-10) This corner is being perpetuated as part of the Chippewa County Remonumentation Program.

Corner was removed by the Chippewa County Road Commission during reconstruction of Riverside Drive and replaced by an empty monument box. Corner position was reestablished in 1991 by W.L. Karr from record witnesses. Found 1/2" iron pin with L.S. cap 27450 in monument box. Established one new witness.

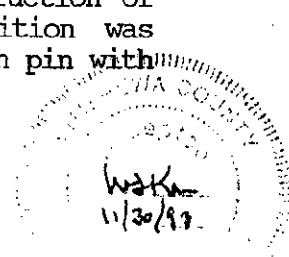

C. Description of monument for corner and accessories established to perpetuate locating the position of the corner:  
(I-10) Corner is a 1/2" x 18" iron pin with L.S. cap 27450 in monument box, 4 feet West of the centerline of Riverside Drive.

Witnesses: Utility Pole (118)	S84°W	40.21'
10" Red Pine (blazed)	N82°W	70.02' (new)
Southwest corner of house	East	70.09'
Utility Pole (118-1)	S64°E	45.76'

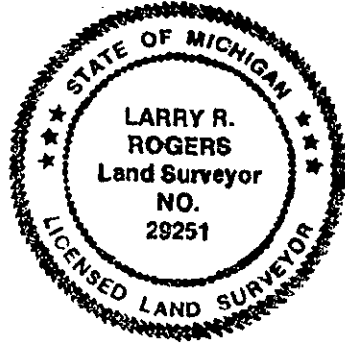

Signed by *[Signature]* Date 12 Nov 1993  
Surveyor's Michigan License No. 29251