

SURVEY &
REMONUMENTATION

MAR 09 1994

Chippewa County Remonumentation Corner

LAND CORNER RECORDATION CERTIFICATE
Filing Requirement of Act 74, Mich. P.A. 1970

RECEIVED FOR RECORD
CHIPPEWA COUNTY
STATE OF MICHIGAN

93 DEC 29 AM 10: 26


For corners in COMMISSION

Chippewa (County)	Located In:	Corner Code #
1. Public Land Survey	T 47N R 1E	I-11
	T _____ R _____	_____
	T _____ R _____	_____
	T _____ R _____	_____
2. Property Controlling in Section	S _____ T _____ R _____	_____
	S _____ T _____ R _____	_____
3. Miscellaneous Property in Sec.	S _____ T _____ R _____	_____
	S _____ T _____ R _____	_____
4. Lot No. _____, Recorded Plat _____		
5. Private Claims _____		

J. Roger Marshall
REGISTER OF DEEDS

Register of Deeds Stamp & File Number

I, Larry R. Rogers, in a field survey on November 11, 19 93, do hereby certify that under requirements of P.A. 74, Michigan P.A. of 1970, the corner points mentioned in lines 1 and 2 above were in conformance with regulations and rules therefore as required in the current manual of survey instructions of the United States Department of the Interior, Bureau of Land Management or by a decree of a Court of Law and/or that the corner points mentioned in lines 3, 4 and 5 above were in conformance with the rules of the Michigan Board of Land Surveyors or by a Decree of a Court of Law; established, re-established, monumented, re-monumented, recovered, found as expressed below:

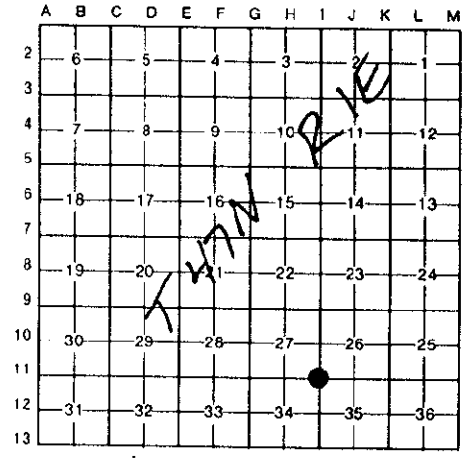

NOTE: Not more than 4 corners, all in the same town and range, may be recorded on this certificate.

A. Description of original monument and accessories and/or subsequent restoration:
(I-11) Section Corner common to Sections 26, 27, 34 & 35, T47N R1E


This corner was previously recorded in 1977 by T.M. Kelly, P.S. 24599, in Liber 1, Page 264 of Chippewa County Corner Records as a 1/2" iron with the following witnesses:

- Anchor Pole N55°E 62.28'
- Anchor Pole (134/B3) S58°W 50.50'
- Telephone Pole (134) N47°W 50.50'

This corner is called for in Eagle's Pleasant View Subdivision as recorded in Liber 7, Page 15 of Plats.

B. Description of corner evidence found and/or method applied in restoring or reestablishing corner:
(I-11) This corner is being perpetuated as part of the Chippewa County Remonumentation Program.

Corner was removed by the Chippewa County Road Commission during reconstruction of Riverside Drive and replaced with an empty monument box at the approximate corner position. The "Kelly" corner position was located in survey work done prior to road reconstruction. In 1991, W.L. Karr replaced the corner in the monument box based on the previous survey work.

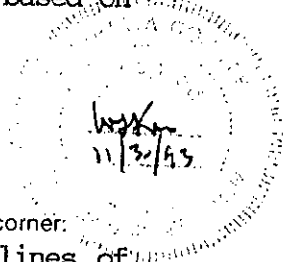

C. Description of monument for corner and accessories established to perpetuate locating the position of the corner:
(I-11) Corner is a 1/2" iron in a monument box in intersecting centerlines of Five Mile Road and Riverside Drive.

- Witnesses: Utility Pole (DRI/136/41) S60°W 58.21'
- Utility Pole (I 34) N62°W 69.76'
- Anchor Pole N54°W 54.43'
- Metal Sign Post N15°E 106.38'
- Anchor Pole S52°E 61.70'



Signed by [Signature] Date 12 Nov 1993

Surveyor's Michigan License No. 29251

NOTE: Bearings are compass bearings corrected for declination.
Distances are to a nail in side of witness objects unless noted.