

SURVEY & REMONUMENTATION

MAR 09 1994

Chippewa County Remonumentation Corner

LAND CORNER RECORDATION CERTIFICATE

Filing Requirement of Act 74, Mich. P.A. 1970

RECEIVED FOR RECORD
CHIPPEWA COUNTY
STATE OF MICHIGAN

93 DEC 29 AM 10: 26

COMMISSION

For corners in

Chippewa

(County)

Located In:

Corner Code #

1. Public Land Survey	T 47N R 1E	I-12
	T _____ R _____	_____
	T _____ R _____	_____
	T _____ R _____	_____
2. Property Controlling in Section	S _____ T _____ R _____	_____
	S _____ T _____ R _____	_____
3. Miscellaneous Property in Sec.	S _____ T _____ R _____	_____
	S _____ T _____ R _____	_____


J. Roger Malott

REGISTER OF DEEDS

Register of Deeds Stamp & File Number

4. Lot No. _____, Recorded Plat _____
5. Private Claims _____

I, Larry R. Rogers, in a field survey on November 10, 19 93, do hereby certify that under requirements of P.A. 74, Michigan P.A. of 1970, the corner points mentioned in lines 1 and 2 above were in conformance with regulations and rules therefore as required in the current manual of survey instructions of the United States Department of the Interior, Bureau of Land Management or by a decree of a Court of Law and/or that the corner points mentioned in lines 3, 4 and 5 above were in conformance with the rules of the Michigan Board of Land Surveyors or by a Decree of a Court of Law; established, re-established, monumented, re-monumented, recovered, found as expressed below:

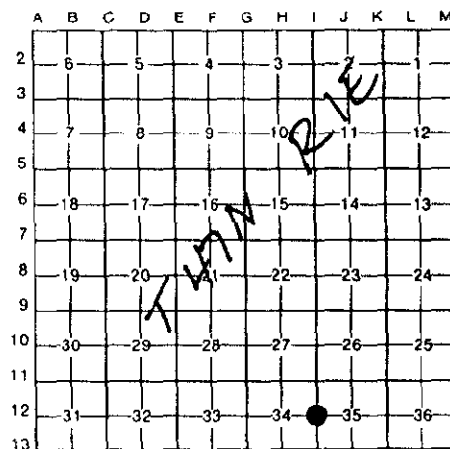

NOTE: Not more than 4 corners, all in the same town and range, may be recorded on this certificate.

A. Description of original monument and accessories and/or subsequent restoration:

(I-12) 1/4 Corner Common to Sections 34 & 35, T47N-R1E


Corner was reestablished in 1983 by William L. Karr and recorded in Liber 6, Page 400 of the Chippewa County Corner Records as a 1/2" iron pin with the following witnesses:

Anchor Pole	N39°E	69.65'
Fence Corner	Due East	45.15'
8" Spruce	S50°W	49.14'
Utility Pole	N39°W	84.30'

B. Description of corner evidence found and/or method applied in restoring or reestablishing corner:

(I-12) This corner is being perpetuated as part of the Chippewa County Remonumentation Program.

Corner was removed by the Chippewa County Road Commission during reconstruction of Riverside Drive, and was replaced by an empty monument box. Corner position was reestablished in the monument box from two remaining witnesses of the 1983 records and previous survey control points. Established three new witnesses.

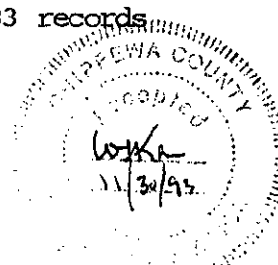

C. Description of monument for corner and accessories established to perpetuate locating the position of the corner:

(I-12) Corner is a 1/2" x 24" iron with L.S. cap 29251 at the Northeast edge of a monument box in the centerline of Riverside Drive.

Witnesses: 9" Spruce (blazed)	N57°W	115.68'
4" Spruce	S21°W	107.65'
Cut off utility pole	N39°E	69.59'
Utility pole (DR1/136/48)	N87°E	47.73'
Corner fence post	East	45.17'



Signed by *[Signature]*

Date 12 Nov 1993

Surveyor's Michigan License No. 29251

NOTE: Bearings are compass bearings corrected for declination.
Distances are to a nail in side of witness objects unless noted.