

1999

**LAND CORNER RECORDATION CERTIFICATE**  
 Filing Requirement of Act 74, Mich. P.A. 1970  
 Chippewa County Remonumentation Corner

For corners in SECTION

Chippewa Located In: Corner Code #

1. Public Land Survey SAME CORNER { T 47N R 1E M-8 ✓  
 T 47N R 2E A-8  
 T \_\_\_ R \_\_\_  
 T \_\_\_ R \_\_\_  
 2. Property Controlling S \_\_\_ T \_\_\_ R \_\_\_  
 in Section S \_\_\_ T \_\_\_ R \_\_\_  
 3. Miscellaneous S \_\_\_ T \_\_\_ R \_\_\_  
 Property in Sec. S \_\_\_ T \_\_\_ R \_\_\_

\$7.00 LAND CORNER  
 \$2.00 MSSR  
 21 JAN 1999 10:30:17 AM Receipt #13123  
 RECEIVED FOR RECORD  
 CHIPPEWA COUNTY - STATE OF MICHIGAN  
 SHARON H. KENNEDY, REGISTER OF DEEDS

BOOK 10 PAGE 354  
 Register of Deeds Stamp & File Number

4. Lot No. \_\_\_\_\_, Recorded Plat \_\_\_\_\_  
 5. Private Claims \_\_\_\_\_

I, Larry R. Rogers, in a field survey on December 08, 1998, do hereby state that under requirements of P.A. 74, Michigan P.A. of 1970, the corner points mentioned in lines 1 and 2 above were in conformance with regulations and rules therefore as required in the current manual of survey instructions of the United States Department of the Interior, Bureau of Land Management or by a decree of a Court of Law and/or that the corner points mentioned in lines 3, 4 and 5 above were in conformance with the rules of the Michigan Board of Land Surveyors or by a Decree of a Court of Law; established, re-established, monumented, recovered, found as expressed below:

NOTE: Not more than 2 corners, all in the same town and range, may be recorded on this certificate.

1	A	B	C	D	E	F	G	H	I	J	K	L	M
2		6		5		4		3		2		1	
3													
4		7		8		9		10		11		12	
5													
6		18		17		16		15		14		13	
7													
8		19		20		21		22		23		24	
9													
10		30		29		28		27		26		25	
11													
12		31		32		33		34		35		36	
13													


A. Description of original monument and accessories and/or subsequent restoration:  
 (M-8) East 1/4 Corner of Section 24, Township 47 North, Range 1 East.  
 The original corner was placed by John Mullett in 1845. Early 1900 County Surveyor notes show 1/4 corner midway between Northeast 1/4 and Southeast corners of Section 24. In 1994, William L. Karr, P.S. 27450 found 1/2" iron pin with P.S. cap number 22428 set by Ronald Bischer. Found corner is within 0.8 feet of a single proportionate position.

B. Description of corner evidence found and/or method applied in restoring or reestablishing corner:  
 (M-8) East 1/4 Corner of Section 24, Township 47 North, Range 1 East.  
 This corner is being perpetuated as part of the Chippewa County Remonumentation Program. Found Bischer 1/2" iron pin with P.S. cap number 22428, 0.5 feet South of corner fence post - old fences to East, West and South. Accepted corner position as found.

C. Description of monument for corner and accessories established to perpetuate locating the position of the corner:  
 (M-8) East 1/4 Corner of Section 24, Township 47 North, Range 1 East.  
 Corner is a 1/2" iron pin with cap number 22428, 0.5 feet South of remains of corner fence post.

Witnesses:

4" Basswood	N10°E	14.88 feet
6" Ash	S80°W	10.76 feet
3" Oak	S45°W	17.91 feet
5" Triple Elm	S38°E	23.58 feet
Steel Fence Post	North	2.00 feet

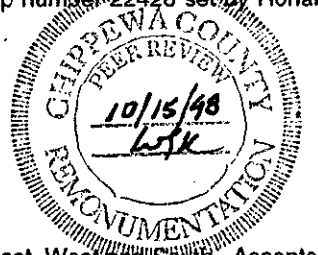

Signed by \_\_\_\_\_ Date 30 DEC 1998

Surveyor's Michigan License No. 29251

NOTE: All bearings are compass bearings corrected for declination (6°W). All distances are to a nail and tag in the side of witness object unless otherwise noted.