
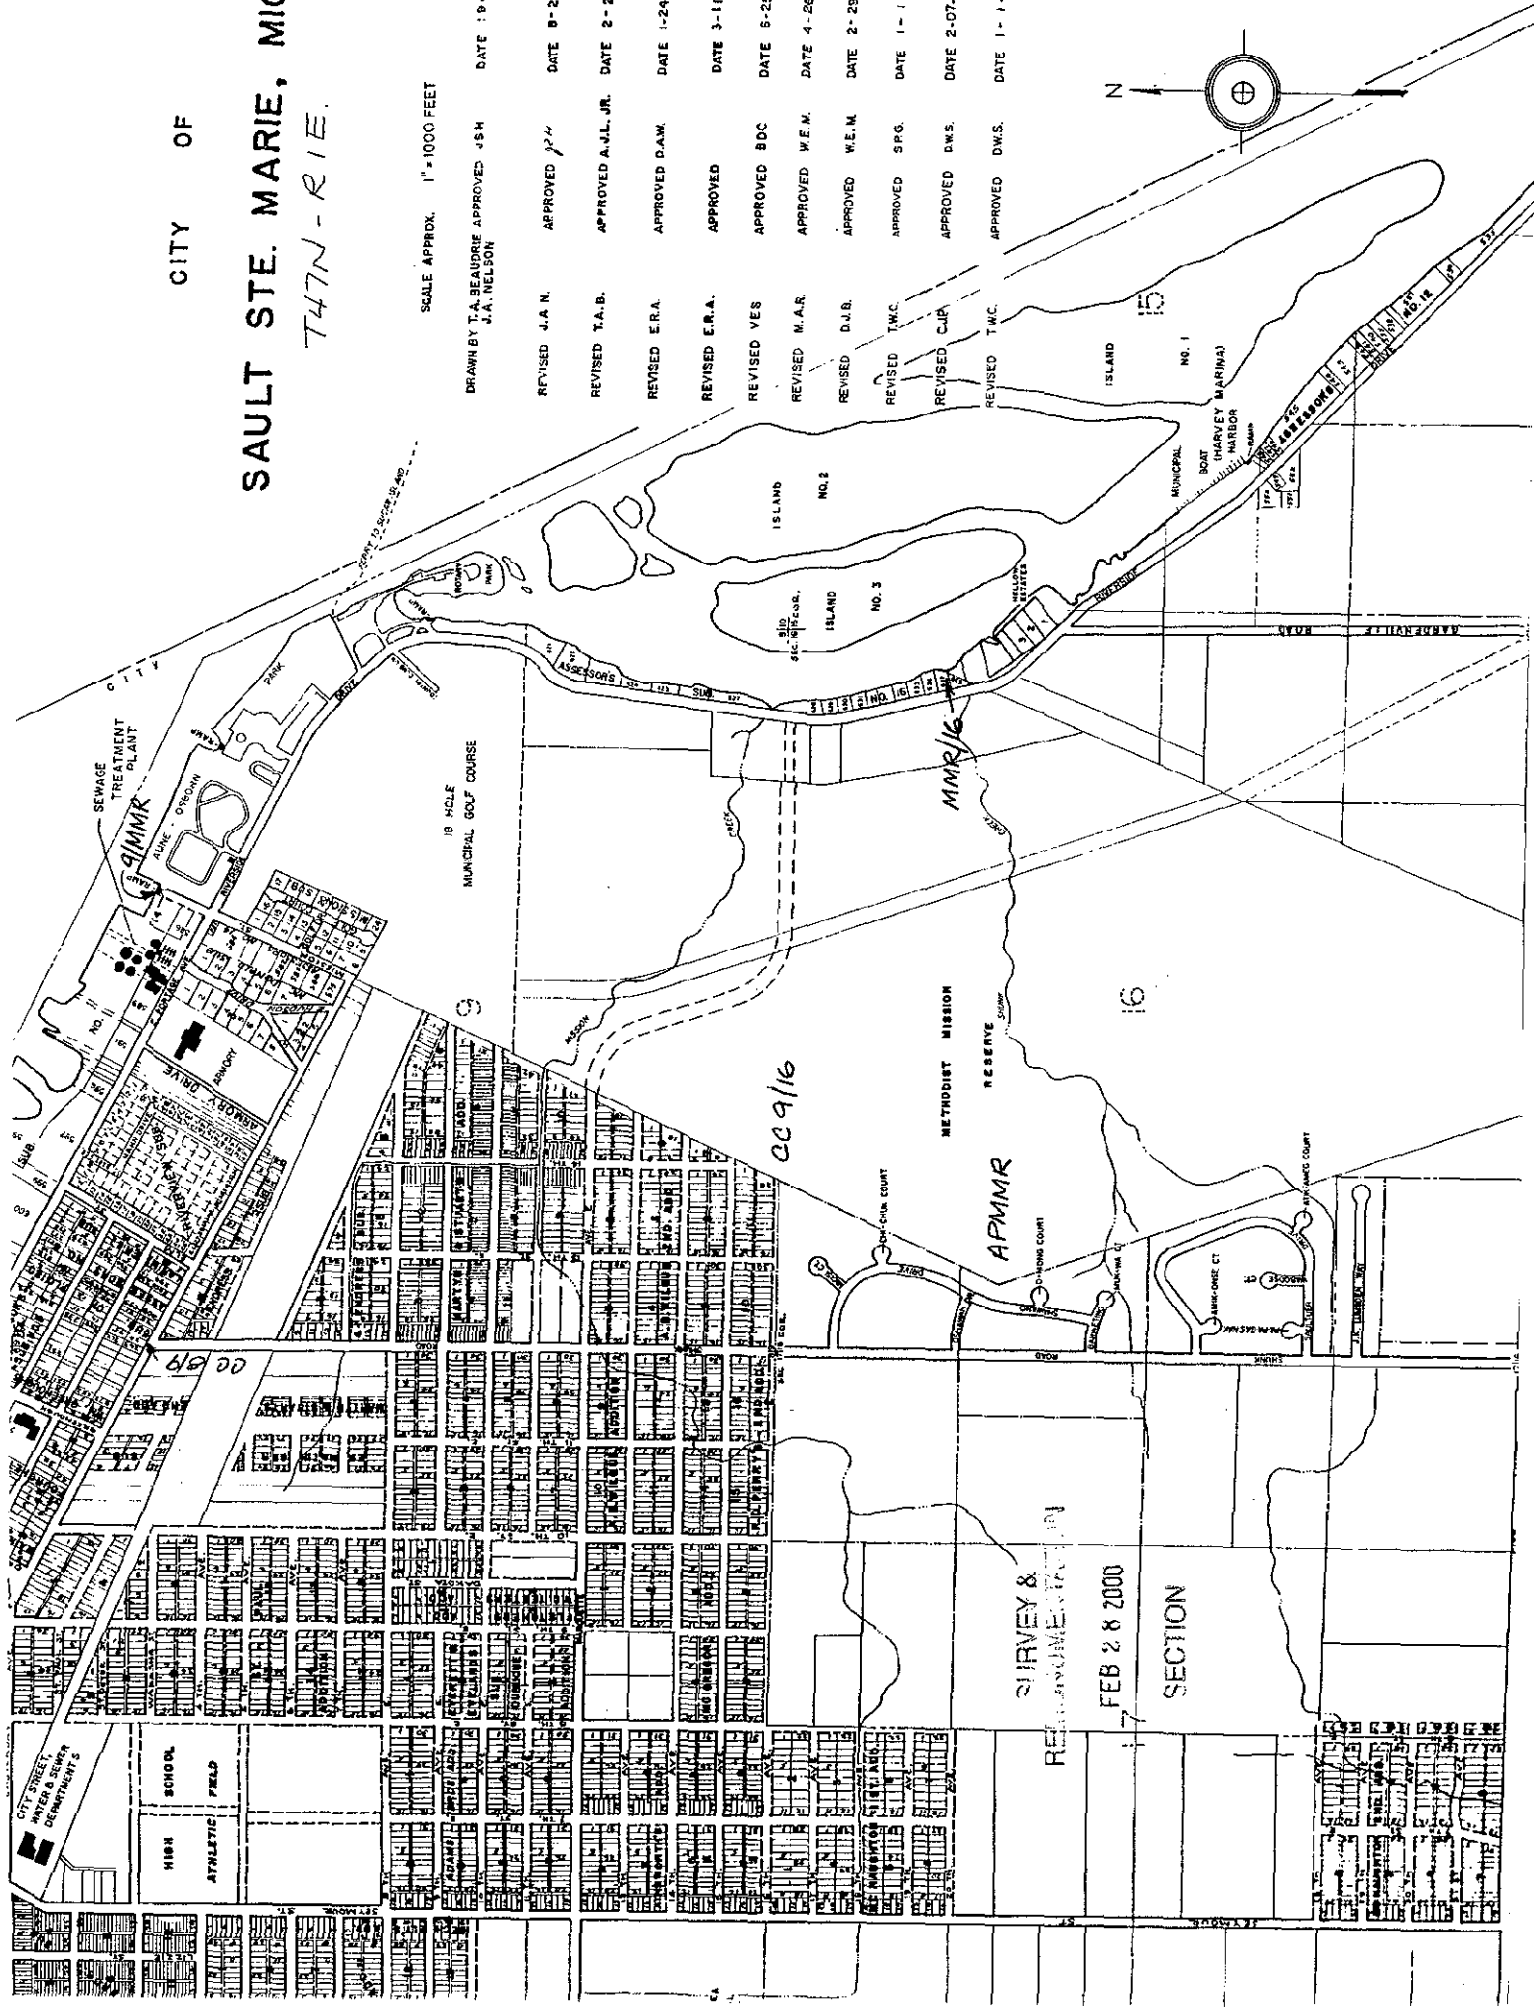


CITY OF
SAULT STE. MARIE, MICHIGAN
T47N-R1E.

SCALE APPROX. 1" = 1000 FEET

DRAWN BY T.A. BEAUDRIE APPROVED J.S.H. DATE 1-9-89
 J.A. NELSON

- REVISED J.A.N. APPROVED J.S.H. DATE 8-28-80
- REVISED T.A.B. APPROVED A.J.L. JR. DATE 2-2-84
- REVISED E.R.A. APPROVED D.A.W. DATE 1-24-83
- REVISED E.R.A. APPROVED DATE 3-11-88
- REVISED VES APPROVED B.D.C. DATE 5-25-89
- REVISED M.A.R. APPROVED W.E.M. DATE 4-28-77
- REVISED D.J.B. APPROVED W.E.M. DATE 2-29-80
- REVISED T.M.C. APPROVED S.P.G. DATE 1-1-86
- REVISED C.J.P. APPROVED D.W.S. DATE 2-07-89
- REVISED T.M.C. APPROVED D.W.S. DATE 1-1-96

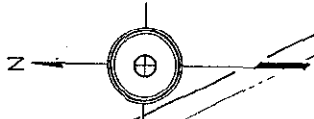

Chippewa Co