

SURVEY & REMONUMENTATION

Chippewa County Remonumentation Corner

RECEIVED FOR RECORD
CHIPPEWA COUNTY
STATE OF MICHIGAN

MAR 09 1994

LAND CORNER RECORDATION CERTIFICATE
Filing Requirement of Act 74, Mich. P.A. 1970

93 DEC 29 AM 10:24

For corners in Chippewa COMMISSION
(County)

Located In: Corner Code =#

J. Roger Malott
REGISTER OF DEEDS


1. Public Land Survey	T 47N R 1W	A-13	
	T 47N R 2W	M-13	Same
	T 46N R 1W	A-1	Corner
	T 46N R 2W	M-1	/
2. Property Controlling in Section	S ___ T ___ R ___		
3. Miscellaneous Property in Sec.	S ___ T ___ R ___		

Register of Deeds Stamp & File Number

4. Lot No. _____, Recorded Plat _____
5. Private Claims _____

I, William L. Karr, in a field survey on May 21, 19 93, do hereby certify that under requirements of P.A. 74, Michigan P.A. of 1970, the corner points mentioned in lines 1 and 2 above were in conformance with regulations and rules therefore as required in the current manual of survey instructions of the United States Department of the Interior, Bureau of Land Management or by a decree of a Court of Law and/or that the corner points mentioned in lines 3, 4 and 5 above were in conformance with the rules of the Michigan Board of Land Surveyors or by a Decree of a Court of Law; established, re-established, monumented, re-monumented, recovered, found as expressed below:

NOTE: Not more than 4 corners, all in the same town and range, may be recorded on this certificate.

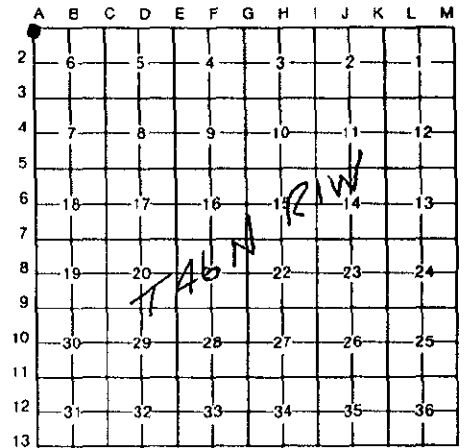

A. Description of original monument and accessories and/or subsequent restoration:
(A-1) Township Corner Common to Sections 1 (T46N-R1W), 6, 31 & 36.


1985: William L. Karr, L.S. 27450, recorded in Liber 6, Page 367 of the Chippewa County Corner Records.
Set 1/2" iron, L.S. 27450, in a monument box.

Power Pole (E 112)	S65°E	113.21'
Metal Sign Post (3" diameter)	S16°W	57.95'
Power Pole (E 113)	S68°W	136.53'
10" White Birch	N17°W	81.45'

B. Description of corner evidence found and/or method applied in restoring or reestablishing corner:

(A-1) This corner is being perpetuated as part of the Chippewa County Remonumentation Program.

Found record corner and witnesses. Accepted corner position as found and added an additional witness.

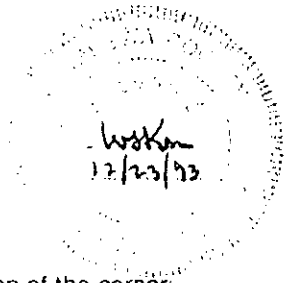

C. Description of monument for corner and accessories established to perpetuate locating the position of the corner:
(A-1) Corner is a 1/2" iron L.S. 27450 in a monument box in the centerline of Six Mile Road.

Witnesses:

Power Pole (E 112)	S65°E	113.08'
Metal Sign Post (Base)	S16°W	58.10'
Power Pole (E 113)	S68°W	136.53'
10" White Birch	N17°W	81.58'
Northwest Corner of Concrete Pad for Utility Box	S48°E	64.44'



Signed by William L. Karr Date 12/23/93

Surveyor's Michigan License No. 27450

NOTE: Bearings are compass bearings corrected for declination.
Distances are to a nail in side of witness objects unless noted.