

CHIPPEWA COUNTY REMONUMENTATION CORNER

MAR 27 1996

LAND CORNER RECORDATION CERTIFICATE
Filing Requirement of Act 74, Mich. P.A. 1970

For corners in

COMMISSION

Chippewa

(County)

Located In:

Corner Code #

1. Public Land Survey	T	47	N	R	1	W	C-11
	T		R				
	T		R				
	T		R				
2. Property Controlling in Section	S		T		R		
	S		T		R		
3. Miscellaneous Property in Sec.	S		T		R		
	S		T		R		

\$ 7.00 LAND CORNER
\$ 2.00 MSSR
28 FEB 96 4:38 P.M. RECEIPT# 459
RECEIVED FOR RECORD
CHIPPEWA COUNTY - STATE OF MICHIGAN
SHARON H. KENNEDY, REGISTER OF DEEDS

Register of Deeds Stamp & File Number

4. Lot No. _____, Recorded Plat _____
5. Private Claims _____

I, Keith R. Waters, in a field survey on 12/13, 1995 do hereby state that under requirements of P.A. 74, Michigan P.A. of 1970, the corner points mentioned in lines 1 and 2 above were in conformance with regulations and rules therefore as required in the current manual of survey instructions of the United States Department of the Interior, Bureau of Land Management or by a decree of a Court of Law and /or that the corner points mentioned in lines 3, 4 and 5 above were in conformance with the rules of the Michigan Board of Land Surveyors or by a Decree of a Court of Law; established, re-established, monumented, recovered, found as expressed below:

NOTE: Not more than 2 corners, all in the same town and range, may be recorded on this certificate.

	A	B	C	D	E	F	G	H	I	J	K	L	M
1													
2		6		5		4		3		2		1	
3													
4		7		8		9		10		11		12	
5													
6		10		17		16		15		14		13	
7													
8		19		20		21		22		23		24	
9													
10		30		29		28		27		26		25	
11													
12		31		32		33		34		35		36	
13													

A. Description of original monument and accessories and/or subsequent restoration:

C-11 Corner Common to Sections 29, 30, 31, & 32, Town 47 North, Range 1 West
1845 - Original ties (James Mullett): Tamarack 12, S43°E 07 links.

Date Unknown - Unrecorded LCRC by unknown surveyor. Corner is a concrete monument, 8" above ground. Witnesses:
5" Poplar, N04°E 9.0' - 3" White Birch, S75°E 19.0' - 4" Poplar, S79°W 21.0' - South 21.0' to centerline of abandoned road - North 32.0' to east-west pole line.

1977 - Recorded plat of "Sault West", Wayne E. Boss, R.L.S. 20703, shows corner as P.O.B. of plat.

1987 - William L. Karr, P.S. 27450, liber 9, page 157, Chippewa County recorded corners. Found concrete monument. Witnesses:
12" Triple Maple, N35°E 68.53' - 10" Balsam Poplar, S09°E 61.25' - 8" Balsam Fir, S43°W 103.36' - Twin 6" Birch, N56°W 98.98'
Corner is also shown in several recorded and unrecorded survey drawings.

B. Description of corner evidence found and/or method applied in restoring or reestablishing corner:

This corner is being perpetuated as part of the Chippewa County Remonumentation Program.
Found a concrete monument approximately 21 feet north of the centerline of east-west asphalt road (5 Mile Road).




C. Description of monument for corner and accessories established to perpetuate locating the position of the corner:

Corner is concrete monument with a 1/2" iron, leaning north, approximately 21 feet north of the centerline of 5 Mile Road (asphalt).
Witnesses:

- 8" Balsam Fir, NORTH 64.45' (Existing blazes and nail/tag P.S. 33142 in side)
- 14" Red Maple in Clump, N34°E 68.45' (Existing blazes, existing nail in side)
- 7" Balsam Fir, S08°E 79.18' (Existing blazes and nail/tag P.S. 33142 in side)
- 11" Balsam Poplar, S39°W 61.33' (Existing blazes, existing nail in side)

Note: Bearings are compass bearings corrected for declination.

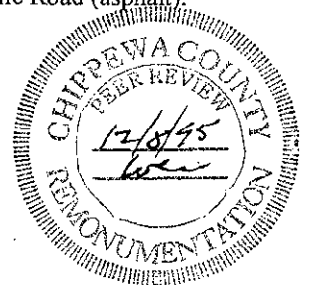

Signed by Keith R. Waters
Surveyor's Michigan License No. 33142

Date December 29, 1995