

SURVEY & REMONUMENTATION

MAR 09 1994

COMMISSION

Chippewa County Remonumentation Corner

RECEIVED FOR RECORD
CHIPPEWA COUNTY
STATE OF MICHIGAN

LAND CORNER RECORDATION CERTIFICATE 93 DEC 29 AM 10:25

Filing Requirement of Act 74, Mich. P.A. 1970

J. Roger Marble
REGISTER OF DEEDS

For corners in

Chippewa (County)	Located In:	Corner Code #
1. Public Land Survey	T <u>47N</u> R <u>1W</u>	<u>D-13</u>
	T _____ R _____	_____
	T _____ R _____	_____
	T _____ R _____	_____
2. Property Controlling in Section	S _____ T _____ R _____	_____
	S _____ T _____ R _____	_____
3. Miscellaneous Property in Sec.	S _____ T _____ R _____	_____
	S _____ T _____ R _____	_____
4. Lot No. _____, Recorded Plat _____		
5. Private Claims _____		

Register of Deeds Stamp & File Number

I, William L. Karr, in a field survey on May 24, 19 93, do hereby certify that under requirements of P.A. 74, Michigan P.A. of 1970, the corner points mentioned in lines 1 and 2 above were in conformance with regulations and rules therefore as required in the current manual of survey instructions of the United States Department of the Interior, Bureau of Land Management or by a decree of a Court of Law and/or that the corner points mentioned in lines 3, 4 and 5 above were in conformance with the rules of the Michigan Board of Land Surveyors or by a Decree of a Court of Law; established, re-established, monumented, re-monumented, recovered, found as expressed below:

NOTE: Not more than 4 corners, all in the same town and range, may be recorded on this certificate.

A. Description of original monument and accessories and/or subsequent restoration:
(D-13) South 1/2 Corner of Section 32 (T47N-R1W)

- 1840: William A. Burt, D.S.
14" Sugar for corner.
5" Fir North 9 links
- 1987: E.S. Strater, L.S. 28424
Survey dated 5/14/87, set 1/2" iron with cap.
MBT Box N12°W 48.60'
Power Pole S30°W 56.21'
Power Pole S66°E 130.31'



B. Description of corner evidence found and/or method applied in restoring or reestablishing corner:
(D-13) This corner is being perpetuated as part of the Chippewa County Remonumentation Program.

Found a 1/2" iron and remains of cap. Corner falls 9' East of a fence to the North. Corner appears to have been set midway and on line between the Southwest and Southeast corners of Section 32. Accepted corner position as found.

C. Description of monument for corner and accessories established to perpetuate locating the position of the corner:
(D-13) Corner is a 1/2" iron, 1.9' North of the centerline of Six Mile Road, 9' East of a fence line to the North and 26.7' East of a fence line to the South.

Witnesses:

Power Pole (E76A)	S67°E	130.30'
Power Pole (E77)	S27°W	56.23'
4" Scotch Pine	N30°W	53.33'
1/2" Iron L.S. 28424	N02°E	50.00'
North 1/2 Corner Section 5	West	27.05'

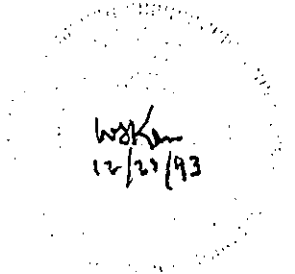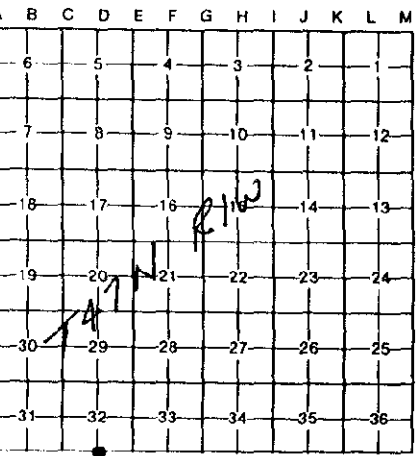

Signed by William L. Karr
Surveyor's Michigan License No. 27450

Date 12/23/93

NOTE: Bearings are compass bearings corrected for declination.
Distances are to a nail in side of witness objects unless noted.