

SURVEY & REMONUMENTATION

CHIPPEWA COUNTY REMONUMENTATION CORNER

APR 27 1995

LAND CORNER RECORDATION CERTIFICATE
Filing Requirement of Act 74, Mich. P.A. 1970

For corners in CHIPPEWA
COMMISSION
(County)

	Located In:	Corner Code #
1. Public Land Survey	T <u>47N</u> R <u>1W</u>	<u>E-10</u>
	T _____ R _____	_____
	T _____ R _____	_____
	T _____ R _____	_____
2. Property Controlling in Section	S _____ T _____ R _____	_____
	S _____ T _____ R _____	_____
3. Miscellaneous Property in Sec.	S _____ T _____ R _____	_____
	S _____ T _____ R _____	_____

\$ 7.00 LAND CORNER
\$ 2.00 MSSR
5 DEC 94 12:30 P.M. RECEIPT# 1519
RECEIVED FOR RECORD
CHIPPEWA COUNTY - STATE OF MICHIGAN
SHARON H. KENNEDY, REGISTER OF DEEDS

Register of Deeds Stamp & File Number

4. Lot No. _____, Recorded Plat _____
5. Private Claims _____

	A	B	C	D	E	F	G	H	I	J	K	L	M
2	6		5		4		3		2		1		
3													
4	7		8		9		10		11		12		
5													
6	18		17		16		15		14		13		
7													
8	19		20		21		22		23		24		
9													
10	30		29		28		27		26		25		
11													
12	31		32		33		34		35		36		
13													

I, Keith R. Waters in a field survey on January 24, 1994, do hereby certify that under requirements of P.A. 74, Michigan P.A. of 1970, the corner points mentioned in lines 1 and 2 above were in conformance with regulations and rules therefore as required in the current manual of survey instructions of the United States Department of the Interior, Bureau of Land Management or by a decree of a Court of Law and/or that the corner points mentioned in lines 3, 4 and 5 above were in conformance with the rules of the Michigan Board of Land Surveyors or by a Decree of a Court of Law; established, re-established, monumented, re-monumented, recovered, found as expressed below:

NOTE: Not more than 4 corners, all in the same town and range, may be recorded on this certificate.

A. Description of original monument and accessories and/or subsequent restoration:

E-10 1/4 Corner Common to Sections 28 & 29, T47N, R1W

Original ties to post: Tamarack 10, N50°E 23 links
Spruce 8, S69°W 12 links




B. Description of corner evidence found and/or method applied in restoring or reestablishing corner:

E-10 (T47N, R1W)

This corner is being re-established as part of the Chippewa County Remonumentation Program.

Found no evidence of corner or its accessories. Re-established corner mid-way on line between Section corners 2663.91 feet north and 2663.91 feet south. Corner falls in the approximate centerline of a pipeline clearing which runs in a northeasterly direction.

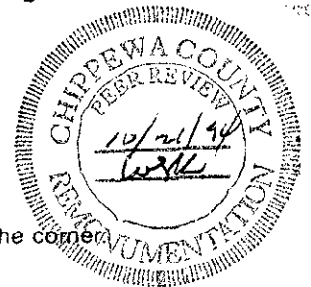

C. Description of monument for corner and accessories established to perpetuate locating the position of the corner:

E-10 (T47N, R1W)

Corner is a 3/4" x 24" rebar with 3/4" aluminum Chippewa County Remonumentation cap in the approximate centerline of a pipeline clearing. Witnesses:

- 10" Tamarack, N51°E 151.08'
- 4" Tamarack, S36°E 60.25'
- 10" Tamarack, S75°W 81.09'
- 5" Tamarack, N50°W 89.22'

Note: Distances are to a nail and tag in the side of the tree. Trees are blazed painted. Bearings are compass bearings corrected for declination. Distances are measured with EDM.

Signed by Keith R. Waters

Date 10-25-94

Surveyor's Michigan License No. 33142