

**CHIPPEWA COUNTY REMONUMENTATION CORNER**

**LAND CORNER RECORDATION CERTIFICATE**  
 Filing Requirement of Act 74, Mich. P.A. 1970

MAR 27 1996

For corners in

Chippewa

(County)

COMMISSIONER

Located In:

Corner Code #

1. Public Land Survey

T47N R1W E-11

T R

T R

T R

2. Property Controlling in Section

S

T R

S

T R

3. Miscellaneous Property in Sec.

S


T R

S

T R

4. Lot No. \_\_\_\_\_, Recorded Plat \_\_\_\_\_

5. Private Claims \_\_\_\_\_

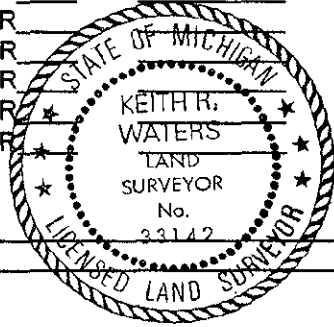

\$ 7.00 LAND CORNER

\$ 2.00 NISSR

28 FEB 96 4:39 P.M.

RECEIPT# 459

RECEIVED FOR RECORD

CHIPPEWA COUNTY - STATE OF MICHIGAN  
 SHARON H. KENNEDY, REGISTER OF DEEDS

Register of Deeds Stamp & File Number

I, Keith R. Waters, in a field survey on 12/20, 1995 do hereby state that under requirements of P.A. 74, Michigan P.A. of 1970, the corner points mentioned in lines 1 and 2 above were in conformance with regulations and rules therefore as required in the current manual of survey instructions of the United States Department of the Interior, Bureau of Land Management or by a decree of a Court of Law and/or that the corner points mentioned in lines 3, 4 and 5 above were in conformance with the rules of the Michigan Board of Land Surveyors or by a Decree of a Court of Law; established, re-established, monumented, recovered, found as expressed below:

**NOTE:** Not more than 2 corners, all in the same town and range, may be recorded on this certificate.

	A	B	C	D	E	F	G	H	I	J	K	L	M
1													
2	6		5		4		3		2		1		
3													
4	7		8		9		10		11		12		
5													
6	18		17		16		15		14		13		
7													
8	19		20		21		22		23		24		
9													
10	30		29		28		27		26		25		
11													
12	31		32		33		34		35		36		
13													

**A. Description of original monument and accessories and/or subsequent restoration:**

E-11 Corner Common to Sections 28, 29, 32, & 33, Town 47 North, Range 1 West

1845 - Original ties (James Mullett): Birch 10, S31°E 17 links - Birch 4, N55°W 11 links.

1973 - Chippewa County Road Commission, liber 3, page 209, Chippewa County recorded corners. Found 1" iron pipe. Witnesses: Fence Post, N50°E 46.45' - REA Pole, N50°W 92.35' - 4" Tree, NW 47.25' - 1" x 4" Hardwood Hub, NORTH 50.00'


1991 - Lawrence E. Weinreis, P.S. 32343, liber 7, page 368, Chippewa County recorded corners. Found 1/2" iron 12" below newly paved road surface. Bearing and distance to found tack in pole check with liber 3, page 209. Placed monument box and 1/2" iron. Witnesses: Fence Post, N67°E 76.13' - 8" Aspen, S07°E 178.89' - Power Pole (E1), S21°W 103.48'

Power Pole (E63/8), N51°W 92.36'

**B. Description of corner evidence found and/or method applied in restoring or reestablishing corner:**

This corner is being perpetuated as part of the Chippewa County Remonumentation Program.

Found a 1/2" iron with cap #32343 in a monument box at the intersection of 5 Mile Road and White Road. Also found all four witness objects as called for in LCRC recorded in liber 7, page 368. Corner position has been used to re-establish 1/4 corner locations 1/2 mile north, south, east, and west. Accepted corner as found.

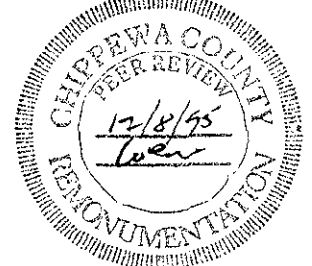

**C. Description of monument for corner and accessories established to perpetuate locating the position of the corner:**

Corner is a 1/2" iron with plastic cap #32343 in a monument box 1.3 feet north of the centerline of 5 Mile Road, at the centerline of White Road to the south. Witnesses:

- Wood Fence Post, N67°E 76.13'
- 8" Balsam Poplar, S07°E 178.89'
- Power Pole (E1), S21°W 103.48'
- Power Pole (E63/8), N51°W 92.36'

Note: Distances are to a nail/tag I.S. 32343 in the side of the witness objects. Tree is blazed and painted. Bearings are compass bearings corrected for declination.

Signed by Keith R. Waters

Date December 29, 1995

Surveyor's Michigan License No. 33142