

LAND CORNER RECORDATION CERTIFICATE
Filing Requirement of Act 74, Mich. P.A. 1970
 Chippewa County Remonumentation Corner


For corners in **SECTION**

Chippewa County	Located in:	Corner Code #
1. Public Land Survey	T47N R1W	G-6
	T R	
	T R	
	T R	
2. Property Controlling in Section	S T R	
	S T R	
3. Miscellaneous Property in Sec.	S T R	
	S T R	
4. Lot No. , Recorded Plat		
5. Private Claims		

BOOK **11** PAGE **57**

47.00 LAND CORNER
 42.00 MSSR
 23 FEB 2000 3:17:15 PM Receipt #2117
 RECEIVED FOR RECORD
 CHIPPEWA COUNTY - STATE OF MICHIGAN
 SHARON H. KENNEDY, REGISTER OF DEEDS

Register of Deeds Stamp & File Number

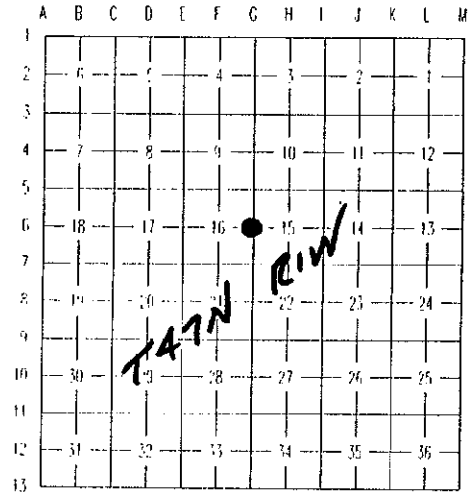

I, William L. Karr, in a field survey on December 13, 1999, do hereby state that under requirements of P.A. 74, Michigan P.A. of 1970, the corner points mentioned in lines 1 and 2 above were in conformance with regulations and rules therefore as required in the current manual of survey instructions of the United States Department of the Interior, Bureau of Land Management or by a decree of a Court of Law and for that the corner points mentioned in lines 3, 4 and 5 above were in conformance with the rules of the Michigan Board of Land Surveyors or by a Decree of a Court of Law; established, re-established, monumented, recovered, found as expressed below:

NOTE: Not more than 2 corners, all in the same town and range, may be recorded on this certificate.

A. Description of original monument and accessories and/or subsequent restoration:

(G-6) 1/4 Corner Between Sections 15 and 16, T. 47 N., R. 1 W.

- 1845 James H. Mullett, set post in original survey.
- 1888 Chippewa County Surveyor records show corners at the Northeast and Southeast corners of section 16, but note that the 1/4 corner was gone. The notes show that the 1/4 post was re-established for the MNP Co and gives distances North as 2653' and South as 2651'.
- 1987 Gerald L. Wiggins, P.S. 23521, recorded the corner in L. 6, P. 384, Chippewa County Corner Records. Wiggins, in a survey for the D.N.R., re-established the corner position mid-way and on-line between the section corners North, and South, and set a 1" pipe with a plastic cap.

B. Description of corner evidence found and/or method applied in restoring or reestablishing corner:

(G-6) 1/4 Corner Between Sections 15 and 16, T. 47 N., R. 1 W.

This corner is being perpetuated as part of the Chippewa County Remonumentation Program.

Recovered the pipe and witnesses established by Wiggins in 1987. The position falls 0.89' South and 0.88' East of being mid-way and on-line between the section corners North and South. The witnesses established by Wiggins are somewhat inconsistent and do not intersect at a common point. Accepted the pipe as found for the 1/4 corner.

C. Description of monument for corner and accessories established to perpetuate locating the position of the corner:

(G-6) 1/4 Corner Between Sections 15 and 16, T. 47 N., R. 1 W.

Corner is a 1" pipe with the remains of a plastic cap inside. The corner falls 4" below grade in the centerline of an ORV trail running Northeast - Southwest.

Witnesses:	9" White Birch	N 20° E	52.51'	(existing witness)
	9" White Pine	N 80° E	26.16'	(existing witness)
	10" Red Pine	S 17° E	39.91'	(existing witness)
	10" White Pine	S 09° W	15.30'	(existing witness)

Bearings are compass bearings, corrected for declination, (7° W), all distances are to a nail and tag in the side of the witness object unless otherwise noted.

Signed by William L. Karr

Date 12-24-99

Surveyor's Michigan License No. 27450

