

**CHIPPEWA COUNTY REMONUMENTATION CORNER**

MAR 27 1996

**LAND CORNER RECORDATION CERTIFICATE 7.00 LAND CORNER**  
 Filing Requirement of Act 74, Mich. P.A. 1970 2.00 HSSR

For corners in

Chippewa

(County)

Located in:

Corner Code #

- |                                    |   |             |
|------------------------------------|---|-------------|
| 1. Public Land Survey              | T <u>47</u> N R <u>1</u> W                | <u>G-11</u> |
|                                    | T <u>    </u> R <u>    </u>               | <u>    </u> |
|                                    | T <u>    </u> R <u>    </u>               | <u>    </u> |
|                                    | T <u>    </u> R <u>    </u>               | <u>    </u> |
| 2. Property Controlling in Section | S <u>    </u> T <u>    </u> R <u>    </u> | <u>    </u> |
|                                    | S <u>    </u> T <u>    </u> R <u>    </u> | <u>    </u> |
| 3. Miscellaneous Property in Sec.  | S <u>    </u> T <u>    </u> R <u>    </u> | <u>    </u> |
|                                    | S <u>    </u> T <u>    </u> R <u>    </u> | <u>    </u> |

28 FEB 96 4:41 P.M. RECEIPT# 459  
 RECEIVED FOR RECORD  
 CHIPPEWA COUNTY - STATE OF MICHIGAN  
 SHARON H. KENNEDY, REGISTER OF DEEDS

Register of Deeds Stamp & File Number

4. Lot No. \_\_\_\_\_, Recorded Plat \_\_\_\_\_  
 5. Private Claims \_\_\_\_\_

I, Keith R. Waters, in a field survey on 12/20, 1995 do hereby state that under requirements of P.A. 74, Michigan P.A. of 1970, the corner points mentioned in lines 1 and 2 above were in conformance with regulations and rules therefore as required in the current manual of survey instructions of the United States Department of the Interior, Bureau of Land Management or by a decree of a Court of Law and /or that the corner points mentioned in lines 3, 4 and 5 above were in conformance with the rules of the Michigan Board of Land Surveyors or by a Decree of a Court of Law; established, re-established, monumented, recovered, found as expressed below:

**NOTE: Not more than 2 corners, all in the same town and range, may be recorded on this certificate.**


A	B	C	D	E	F	G	H	I	J	K	L	M
1												
2	6	5	4	3	2	1						
3												
4	7	8	9	10	11	12						
5												
6	18	17	16	15	14	13						
7												
8	19	20	21	22	23	24						
9												
10	30	29	28	27	26	25						
11												
12	31	32	33	34	35	36						
13												

**A. Description of original monument and accessories and/or subsequent restoration:**

- G-11 Corner: Common to Sections 27, 28, 33, & 34, Town 47 North, Range 1 West  
 1845 - Original ties (James Mullett): Hemlock 10, S48°E 09 links - Birch 12, N64°W 24 links.  
 1925 - Chippewa County Surveyor notes. Stone 15" below surface.  
 1982 - William L. Karr, P.S. 27450, liber 6, page 134, Chippewa County recorded corners. Found 5/8" rod in road centerline.  
 1990 - Larry R. Rogers, P.S. 29251, liber 7, page 395, Chippewa County recorded corners. Corner destroyed in road re-construction work. Corner position re-established from survey control in the area and two existing record ties. Witnesses:  
 3" Spruce, N50°E 47.16' - 10" Aspen, S29°E 73.65' - Power Pole (E3802), S03°W 33.76' - 4" Spruce, N58°W 72.85'

**B. Description of corner evidence found and/or method applied in restoring or reestablishing corner:**

This corner is being perpetuated as part of the Chippewa County Remonumentation Program.  
 Found a 1/2" iron with plastic cap #29251 and all four witness objects as called for in LCRC recorded in liber 7, page 395.  
 Corner is approximately 253 feet west of the centerline of north-south railroad tracks to the east, at a tree line to the north.  
 Accepted corner as found.

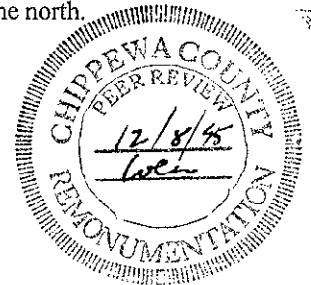

**C. Description of monument for corner and accessories established to perpetuate locating the position of the corner:**

- Corner is a 1/2" iron with a plastic cap #29251 in the approximate centerline of 5 Mile Road (asphalt), approximately 253 feet west of the centerline of north-south railroad tracks, at a tree line to the north. Witnesses:  
 3" Spruce, N50°E 47.12' (Set nail/tag P.S. 33142 in side)  
 10" Aspen, S29°E 73.65' (Existing nail in side)  
 Power Pole (E3802), S03°W 33.76' (Existing nail in side)  
 5" Balsam Fir, N58°W 72.85' (Existing nail in side)



Note: Bearings are compass bearings corrected for declination.

Signed by Keith R. Waters  
 Surveyor's Michigan License No. 33142

Date December 29, 1995