

LIBRARY & REMONUMENTATION

MAR 09 1994

COMMISSION

Chippewa County Remonumentation Corner

RECEIVED FOR RECORD
CHIPPEWA COUNTY
STATE OF MICHIGAN

LAND CORNER RECORDATION CERTIFICATE
Filing Requirement of Act 74, Mich. P.A. 1970

93 DEC 29 AM 10:25

J. Roger Malotte
REGISTER OF DEEDS

For corners in
Chippewa

(County)

Located In:


Corner Code #

1. Public Land Survey	T <u>47N</u> R <u>1W</u>	<u>G-13</u>
	T _____ R _____	_____
	T _____ R _____	_____
	T _____ R _____	_____
2. Property Controlling in Section	S _____ T _____ R _____	_____
	S _____ T _____ R _____	_____
3. Miscellaneous Property in Sec.	S _____ T _____ R _____	_____
	S _____ T _____ R _____	_____

Register of Deeds Stamp & File Number

- 4. Lot No. _____, Recorded Plat _____
- 5. Private Claims _____


I, William L. Karr, in a field survey on May 24, 19 93, do hereby certify that under requirements of P.A. 74, Michigan P.A. of 1970, the corner points mentioned in lines 1 and 2 above were in conformance with regulations and rules therefore as required in the current manual of survey instructions of the United States Department of the Interior, Bureau of Land Management or by a decree of a Court of Law and/or that the corner points mentioned in lines 3, 4 and 5 above were in conformance with the rules of the Michigan Board of Land Surveyors or by a Decree of a Court of Law; established, re-established, monumented, re-monumented, recovered, found as expressed below:

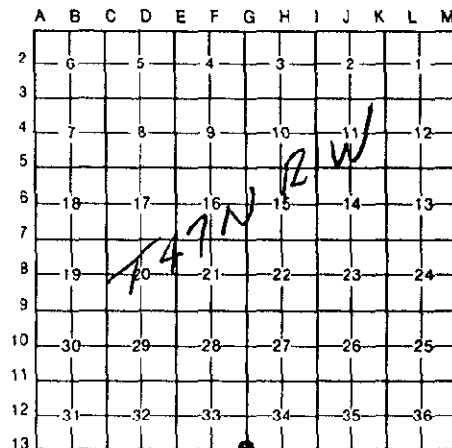

NOTE: Not more than 4 corners, all in the same town and range, may be recorded on this certificate.

A. Description of original monument and accessories and/or subsequent restoration:
(G-13) Standard Corner Common to Sections 33 & 34 (T47N-R1W)

1840: William A. Burt, set post.
6" Aspen N86°E 21 links
8" White Birch N82°W ? links

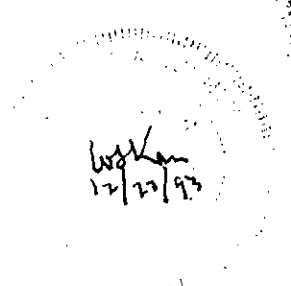

B. Description of corner evidence found and/or method applied in restoring or reestablishing corner:
(G-13) This corner is being perpetuated as part of the Chippewa County Remonumentation Program.

Found a 1/2" iron L.S. 27450 in a monument box. Corner has been used in many surveys. Originally re-established on the same line as the North 1/4 and Northeast Corner of Section 4 at record GLO distance from the Northeast corner of Section 4 in previous survey. Accepted corner position as found.

C. Description of monument for corner and accessories established to perpetuate locating the position of the corner:
(G-13) Corner is a 1/2" iron L.S. 27450 in a monument box, 1' South of the centerline of Six Mile Road and 15' West of the centerline of a railroad bridge.

Witnesses:

Bridge Post	N20°E	20.84'
Guard Rail Post	S18°W	14.71'
Power Pole (With Soo Line Sign)	S72°W	141.90'
Guard Rail Post	N76°W	42.97'
Closing corner 4/3 (1/2" Iron L.S. 27450)	West	14.52'



Signed by William L. Karr Date 12/23/93

Surveyor's Michigan License No. 27450

NOTE: Bearings are compass bearings corrected for declination.
Distances are to a nail in side of witness objects unless noted.