

LAND CORNER RECORDATION CERTIFICATE
Filing Requirement of Act 74, Mich. P.A. 1970
 Chippewa County Remonumentation Corner

For corners in SECTION


Chippewa County	Located in:	Corner Code #
1. Public Land Survey	T47N R1W	H-5
	T R	
	T R	
	T R	
2. Property Controlling in Section	S T R	
	S T R	
3. Miscellaneous Property in Sec.	S T R	
	S T R	
4. Lot No. , Recorded Plat		
5. Private Claims		

BOOK **11** PAGE **58**

\$7.00 LAND CORNER
 \$2.00 MSSR
 23 FEB 2000 3:18:05 PM Receipt #2117
 RECEIVED FOR RECORD
 CHIPPEWA COUNTY - STATE OF MICHIGAN
 SHARON H. KENNEDY, REGISTER OF DEEDS
 Register of Deeds Stamp & File Number

I, William L. Karr, in a field survey on September 7, 1999, do hereby state that under requirements of P.A. 74, Michigan P.A. of 1970, the corner points mentioned in lines 1 and 2 above were in conformance with regulations and rules therefore as required in the current manual of survey instructions of the United States Department of the Interior, Bureau of Land Management or by a decree of a Court of Law and /or that the corner points mentioned in lines 3, 4 and 5 above were in conformance with the rules of the Michigan Board of Land Surveyors or by a Decree of a Court of Law; established, re-established, monumented, recovered, found as expressed below:

NOTE: Not more than 2 corners, all in the same town and range, may be recorded on this certificate.

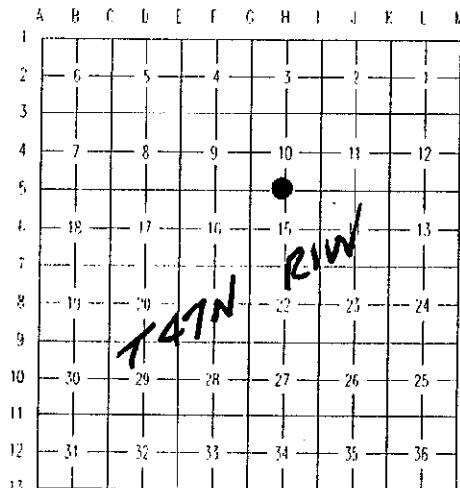

A. Description of original monument and accessories and/or subsequent restoration:

(H-5) 1/4 Corner Between Sections 10 and 15, T. 47 N., R. 1 W.

- 1845 James H. Mullett set post in original survey.
- 1918 Notes in the Chippewa County Surveyors office, a survey of section 15 shows the North line as measuring 5223' and evenly divided.
- 1937 Notes in the Chippewa County Surveyors office, a survey of section 10 shows the South line as measuring 5218' and evenly divided.
- 1984 William L. Karr, P.S. 27450, recorded corner in L. 6, P. 98, Chippewa County Corner Records. Found no evidence of original corner, found a 3/4" solid rod in the intersecting centerlines, roads East, West and North.
- 1992 Keith R. Waters, P.S. 33142, Certificate of Survey in section 10, shows corner as a found iron.
- 1998 Larry R. Rogers, P.S. 29251, Certificate of Survey in section 15, shows corner as a found 3/4" pin in monument box.

B. Description of corner evidence found and/or method applied in restoring or reestablishing corner:

(H-5) 1/4 Corner Between Sections 10 and 15, T. 47 N., R. 1 W.

This corner is being perpetuated as part of the Chippewa County Remonumentation Program.

Found the 3/4" iron recorded in 1984 and used in subsequent surveys. The monument box was placed during road reconstruction in the mid 1990's. The 1/2 miles measure 2615.77' to the West, and 2616.08' to the East. Accepted the 3/4" iron for the corner.



C. Description of monument for corner and accessories established to perpetuate locating the position of the corner:

(H-5) 1/4 Corner Between Sections 10 and 15, T. 47 N., R. 1 W.

The corner is a 3/4" iron in a small monument box in the centerline of West 16th Ave. East and West, and on the centerline of 24th Street to the North.


Witnesses:	10" White Birch	N 44° E	118.56'	(existing witness)
	8" Spruce	S 52° E	89.89'	(existing witness)
	Power Pole (H8/1)	S 67° W	101.94'	
	Power Pole	N 70° W	78.16'	

Bearings are compass bearings, corrected for declination, (7° W), all distances are to a nail and tag in the side of the witness object unless otherwise noted.

Signed by William L. Karr

Date 12-25-99

Surveyor's Michigan License No. 27450

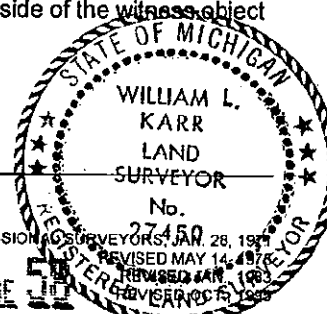

FORM APPROVED BY MICHIGAN STATE BOARD OF PROFESSIONAL SURVEYORS, JAN. 28, 1974

BOOK **11** PAGE **58**