

**CHIPPEWA COUNTY REMONUMENTATION CORNER**

MAR 27 1996

**LAND CORNER RECORDATION CERTIFICATE**  
Filing Requirement of Act 74, Mich. P.A. 1970

For corners in

Chippewa <small>(County)</small>	Located in:	Corner Code #
1. Public Land Survey	T47N R 1W	H-9
	T R	
	T R	
	T R	
2. Property Controlling in Section	S T R	
	S T R	
3. Miscellaneous Property in Sec.	S T R	
	S T R	

\$ 7.00 LAND CORNER  
\$ 2.00 MSSR  
28 FEB 96 4:41 P.M. RECEIPT# 459  
RECEIVED FOR RECORD  
CHIPPEWA COUNTY - STATE OF MICHIGAN  
SHARON H. KENNEDY, REGISTER OF DEEDS

Register of Deeds Stamp & File Number

4. Lot No. \_\_\_\_\_, Recorded Plat \_\_\_\_\_  
5. Private Claims \_\_\_\_\_

I, Keith R. Waters, in a field survey on 12/11, 1995 do hereby state that under requirements of P.A. 74, Michigan P.A. of 1970, the corner points mentioned in lines 1 and 2 above were in conformance with regulations and rules therefore as required in the current manual of survey instructions of the United States Department of the Interior, Bureau of Land Management or by a decree of a Court of Law and/or that the corner points mentioned in lines 3, 4 and 5 above were in conformance with the rules of the Michigan Board of Land Surveyors or by a Decree of a Court of Law; established, re-established, monumented, recovered, found as expressed below:

A	B	C	D	E	F	G	H	I	J	K	L	M
1												
2	6	5	4	3	2	1						
3												
4	7	8	9	10	11	12						
5												
6	10	17	16	15	14	13						
7												
8	19	20	21	22	23	24						
9												
10	30	29	28	27	26	25						
11												
12	31	32	33	34	35	36						
13												

**NOTE:** Not more than 2 corners, all in the same town and range, may be recorded on this certificate.

**A. Description of original monument and accessories and/or subsequent restoration:**

H-9 1/4 Corner Common to Sections 22 and 27, T47N, R1W  
1845 - Original ties (James Mullett): Hemlock 16, N32°E 13 links - Fir 6, S60°W 15 links

Circa 1920 - County Surveyor notes indicate a small concrete monument set by either Stillwell or Carleton from the above mentioned original hemlock bearing tree.


1985 - James L. Fletcher, RLS 19830. Unrecorded LCRC indicates a found 2" concrete monument as called for in County Surveyor notes.  
Witnesses: 4" Spruce, N64°W 95.45' - Corner fence post, S05°W 23.80' - 6" Aspen, S47°W 34.19' - 7" Spruce, N68°E 48.90'

**B. Description of corner evidence found and/or method applied in restoring or reestablishing corner:**

This corner is being perpetuated as part of the Chippewa County Remonumentation Program.  
Found a 1/2" x 24" rebar along with 2 spruce and corner fence post witnesses as called for in above mentioned LCRC. Corner falls on the north edge of an east-west gravel road, which appears to have been built up considerably since 1985. Iron checks well with existing witnesses and also with other found corners in Section 22, which are shown in a section subdivision sketch by Fletcher. Accepted corner location as found, replaced 1/2" rebar with a 3/4" x 24" rebar and plastic Chippewa County Remonumentation cap and established new witness objects.

**C. Description of monument for corner and accessories established to perpetuate locating the position of the corner:**

Corner is a 3/4" x 24" rebar with a plastic Chippewa County Remonumentation cap on the north edge of an east-west gravel road (Four Mile Road), on the extension of a fence line to the south.  
Witnesses:  
10" Spruce, N71°E 48.81'      Note: Bearings are compass bearings corrected for declination. Distances are to a nail  
10" Spruce, N63°W 95.62'      with tag #33142 in the side of the tree. Trees are blazed and painted.  
10" White Birch, S40°E 91.22'  
6" White Birch, S67°W 103.90'

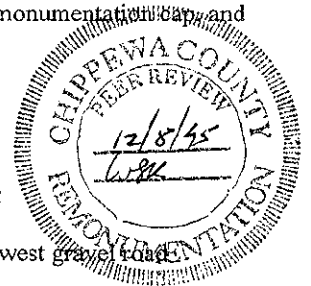

Signed by Keith R. Waters  
Surveyor's Michigan License No. 33142

Date Dec. 29, 1995

