

CHIPPEWA COUNTY REMONUMENTATION CORNER

MAR 27 1996

LAND CORNER RECORDATION CERTIFICATE
Filing Requirement of Act 74, Mich. P.A. 1970

For corners in CHIPPEWA COMMISSION

Chippewa (County)	Located in:	Corner Code #
1. Public Land Survey	T <u>47</u> N R <u>1</u> W	H-11
	T _____ R _____	_____
	T _____ R _____	_____
	T _____ R _____	_____
2. Property Controlling in Section	S _____ T _____ R _____	_____
	S _____ T _____ R _____	_____
3. Miscellaneous Property in Sec.	S _____ T _____ R _____	_____
	S _____ T _____ R _____	_____

\$ 7.00 LAND CORNER
28 FEB 96 4:42 P.M. RECEIPT# 459
RECEIVED FOR RECORD
CHIPPEWA COUNTY - STATE OF MICHIGAN
SHARON H. KENNEDY, REGISTER OF DEEDS
\$ 2.00 NISSR

Register of Deeds Stamp & File Number

4. Lot No. _____, Recorded Plat _____
5. Private Claims _____

I, Keith R. Waters, in a field survey on 12/20, 1995 do hereby state that under requirements of P.A. 74, Michigan P.A. of 1970, the corner points mentioned in lines 1 and 2 above were in conformance with regulations and rules therefore as required in the current manual of survey instructions of the United States Department of the Interior, Bureau of Land Management or by a decree of a Court of Law and /or that the corner points mentioned in lines 3, 4 and 5 above were in conformance with the rules of the Michigan Board of Land Surveyors or by a Decree of a Court of Law, established, re-established, monumented, recovered, found as expressed below:

NOTE: Not more than 2 corners, all in the same town and range, may be recorded on this certificate.

	A	B	C	D	E	F	G	H	I	J	K	L	M
1													
2		6		5		4		3		2		1	
3													
4		7		8		9		10		11		12	
5													
6		18		17		16		15		14		13	
7													
8		19		20		21		22		23		24	
9													
10		30		29		28		27		26		25	
11								●					
12		31		32		33		34		35		36	
13													


A. Description of original monument and accessories and/or subsequent restoration:

H-11 1/4 Corner Common to Sections 27 & 34, Town 47 North, Range 1 West
1845 - Original ties (James Mullett): Cedar 10, S21°E 09 links - Cedar 12, N50°E 10 links.

1990 - Larry R. Rogers, P.S. 29251, liber 7, page 395, Chippewa County recorded corners. Corner position re-established on line and midway between the Northwest and Northeast corners of Section 34. Witnesses:
5" Spruce, N55°E 64.85' - Power Pole, S40°E 56.99' - Power Pole (16/11B2), N53°W 94.78'
Southwest Corner of House Foundation, N36°W 119.11'

B. Description of corner evidence found and/or method applied in restoring or reestablishing corner:

This corner is being perpetuated as part of the Chippewa County Remonumentation Program.
Found a 1/2" iron with plastic cap #29251 and all four witness objects as called for in LCRC recorded in liber 7, page 395.
Corner is on line between recovered Section corners 2607.04 feet east and 2607.04 feet west.
Accepted corner as found.

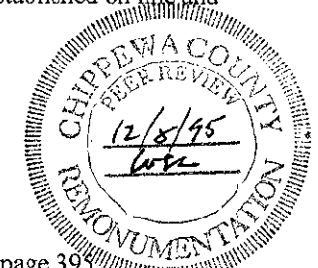

C. Description of monument for corner and accessories established to perpetuate locating the position of the corner:

Corner is a 1/2" iron with a plastic cap #29251 in the approximate centerline of 5 Mile Road (asphalt), at the approximate location of a meandering fence line to the south. Witnesses:
5" Spruce, N55°E 64.85'
Power Pole, S40°E 56.99'
Power Pole (116/11B2), N53°W 94.78'
Southwest corner of house foundation, N36°W 119.11'

Note: Distances to spruce and power poles are to a nail in the side. Bearings are compass bearings corrected for declination.

Signed by Keith R. Waters Date December 29, 1995
Surveyor's Michigan License No. 33142