


LAND CORNER RECORDATION CERTIFICATE
Filing Requirement of Act 74, Mich. P.A. 1970
 Chippewa County Remonumentation Corner

For corners in **SECTION**

Chippewa County	Located in:	Corner Code #
1. Public Land Survey	T47N R1W I-6	
	T R	
	T R	
	T R	
2. Property Controlling in Section	S T R	
	S T R	
3. Miscellaneous Property in Sec.	S T R	
	S T R	
4. Lot No. , Recorded Plat		
5. Private Claims		

BOOK **11** PAGE **62**

\$7.00 LAND CORNER
 \$2.00 MSSR
 23 FEB 2000 3:23:47 PM Receipt #2117
 RECEIVED FOR RECORD
 CHIPPEWA COUNTY - STATE OF MICHIGAN
 SHARON H. KENNEDY, REGISTER OF DEEDS
 Register of Deeds Stamp & File Number

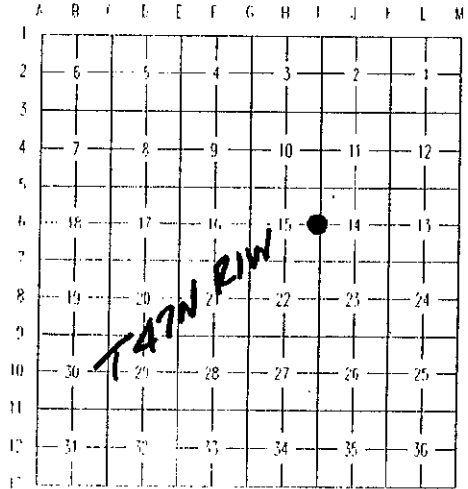

I, William L. Karr, in a field survey on September 7, 1999, do hereby state that under requirements of P.A. 74, Michigan P.A. of 1970, the corner points mentioned in lines 1 and 2 above were in conformance with regulations and rules therefore as required in the current manual of survey instructions of the United States Department of the Interior, Bureau of Land Management or by a decree of a Court of Law and /or that the corner points mentioned in lines 3, 4 and 5 above were in conformance with the rules of the Michigan Board of Land Surveyors or by a Decree of a Court of Law; established, re-established, monumented, recovered, found as expressed below:

NOTE: Not more than 2 corners, all in the same town and range, may be recorded on this certificate.

A. Description of original monument and accessories and/or subsequent restoration:

(I-6) 1/4 Corner Between Sections 14 and 15, T. 47 N., R. 1 W.

- 1845 James H. Mullett set post for corner in original survey.
- 1908 Sketches and notes in County Surveyors office show the mile measuring 5300' but make no mention of 1/4 corner.
- 1915 & 1918 Notes and sketches in County Surveyors office show the mile measuring 5282 and evenly divided but make no mention of 1/4 corner.
- 1980 Thomas M. Kelly, P.S. 24599, certificate of survey in section 14 and recorded in L. 2, P. 165, Chippewa County Survey Records, shows 1/4 corner and witnesses.
- 1984 William L. Karr, P.S. 27450, found 3/4" pipe and cap set by Kelly. Found no evidence of original corner, accepted Kelly's position and recorded corner in L. 6, P. 93, Chippewa County Corner Records.
- 1986 Larry R. Rogers, P.S. 29251, in a survey for the City of Sault Ste. Marie Engineering Department in section 14, shows the corner as a 1/2" iron in a monument box.
- 1990 Keith R. Waters, P.S. 33142, certificate of survey in section 15 shows corner as a 1/2" iron in a monument box.

B. Description of corner evidence found and/or method applied in restoring or reestablishing corner:

(I-6) 1/4 Corner Between Sections 14 and 15, T. 47 N., R. 1 W.

This corner is being perpetuated as part of the Chippewa County Remonumentation Program.

Found a 1/2" iron in a small monument box in a position that matches the one that was set by Kelly and recorded by Karr, the pipe was replaced with the iron and monument box during road reconstruction in the mid 1980's. Could find no contrary evidence to the current location or the corner in available public records. Accepted the corner position as found.

C. Description of monument for corner and accessories established to perpetuate locating the position of the corner:

(I-6) 1/4 Corner Between Sections 14 and 15, T. 47 N., R. 1 W.

The corner is a 1/2" iron in a small monument box in the centerline of 20th Street West.

Witnesses:	Power Pole J11/9	N 14° E	79.44'
	12" Aspen	N 63° E	67.33'
	10" Ash	S 46° W	67.59'
	8" Ash	N 77° W	44.93'

BOOK **11** PAGE **62**

Bearings are compass bearings, corrected for declination (7° W), all distances are to a nail and tag in the side of the witness object unless otherwise noted.

Signed by William L. Karr

Date 12-29-99

Surveyor's Michigan License No. 27450

