

1933

CHIPPewa COUNTY REMONUMENTATION CORNER

RECEIVED FOR RECORD
CHIPPewa COUNTY
STATE OF MICHIGAN

COMMISSION

LAND CORNER RECORDATION CERTIFICATE

Filing Requirement of Act 74, Mich. P.A. 1970

93 DEC -3 PM 3:57

For corners in
Chippewa

(County)	Located In:	Corner Code #
1. Public Land Survey	T <u>47N</u> R <u>1W</u>	<u>I-7</u>
	T _____ R _____	_____
	T _____ R _____	_____
	T _____ R _____	_____
2. Property Controlling in Section	S _____ T _____ R _____	_____
	S _____ T _____ R _____	_____
3. Miscellaneous Property in Sec.	S _____ T _____ R _____	_____
	S _____ T _____ R _____	_____

J. Roger Malick
REGISTER OF DEEDS

Register of Deeds Stamp & File Number

4. Lot No. _____, Recorded Plat _____
5. Private Claims _____

I, Keith R. Waters, in a field survey on July 29, 19 93, do hereby certify that under requirements of P.A. 74, Michigan P.A. of 1970, the corner points mentioned in lines 1 and 2 above were in conformance with regulations and rules therefore as required in the current manual of survey instructions of the United States Department of the Interior, Bureau of Land Management or by a decree of a Court of Law and/or that the corner points mentioned in lines 3, 4 and 5 above were in conformance with the rules of the Michigan Board of Land Surveyors or by a Decree of a Court of Law; established, re-established, monumented, re-monumented, recovered, found as expressed below:

NOTE: Not more than 4 corners, all in the same town and range, may be recorded on this certificate.

A. Description of original monument and accessories and/or subsequent restoration:

I-7 Section Corner Common to Sections 14, 15, 22, & 23, T47N, R1W

This corner is recorded in liber 3, page 63, of Chippewa County corner records (1962), by the Chippewa County Road Commission, as a 1" iron pipe with the following witnesses: Fence Post, S50°W 38.18' P. Pole, N30°E 33.02' T. Pole, S55°E 64.93'

Corner is shown on a survey recorded in liber 2 of surveys, page 134, by Thomas M. Kelly, R.L.S. 24599 (1979), as a 1/2" rered with the same ties as above.

B. Description of corner evidence found and/or method applied in restoring or reestablishing corner:

I-7 (T47N, R1W)

This corner is being perpetuated as part of the Chippewa County Remonumentation Program.

Found a 1/2" iron pin at the intersection of 3 Mile Road east-west, Baker Side Road to the south, and 20th Street to the north as shown in survey recorded in liber 2 of surveys, page 134. Corner has been used in numerous surveys in all four adjoining sections. All witness objects from previous recording gone. Accepted corner as found and established new witness objects



C. Description of monument for corner and accessories established to perpetuate locating the position of the corner:

I-7 (T47N, R1W)

Corner is a 1/2" iron pin at the intersection of 3 Mile Road, Baker Side Road, and 20th Street. Witnesses:

- Power Pole (L11-10), N42°E 37.31'
- Power Pole (E-1), S41°E 75.07'
- Power Pole (L10-2), N79°W 142.14'
- Nail w/cap 24599 in Power Pole (E-101), S42°W 77.33'

Note: Unless noted otherwise, distances are to a nail and tag in the side of witness object. Bearings are are compass bearings corrected for declination. Distances measured with EDM.

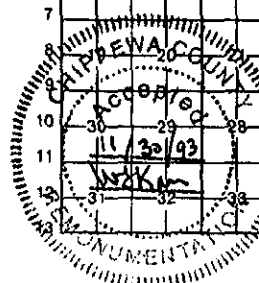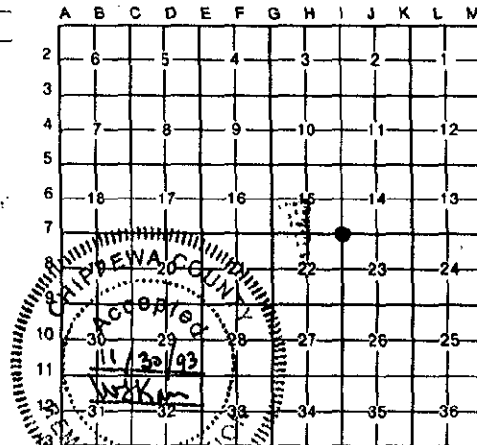

Signed by Keith R. Waters

Date 11-30-93

Surveyor's Michigan License No. 33142