

MAR 2 1996 CHIPPEWA COUNTY REMONUMENTATION CORNER

COMMISSIONER LAND CORNER RECORDATION CERTIFICATE
Filing Requirement of Act 74, Mich. P.A. 1970

For corners in

Chippewa	Located In:	Corner Code #
(County)		
1. Public Land Survey	T 47N R 1W	I-10
	T _____ R _____	_____
	T _____ R _____	_____
	T _____ R _____	_____
2. Property Controlling in Section	S _____ T _____ R _____	_____
	S _____ T _____ R _____	_____
3. Miscellaneous Property in Sec.	S _____ T _____ R _____	_____
	S _____ T _____ R _____	_____

\$ 7.00 LAND CORNER
\$ 2.00 HSSR
28 FEB 96 4:43 P.M. RECEIPT# 459
RECEIVED FOR RECORD
CHIPPEWA COUNTY - STATE OF MICHIGAN
SHARON H. KENNEDY, REGISTER OF DEEDS

Register of Deeds Stamp & File Number

4. Lot No. _____, Recorded Plat _____
5. Private Claims _____

I, Keith R. Waters, in a field survey on 12/14, 1995 do hereby state that under requirements of P.A. 74, Michigan P.A. of 1970, the corner points mentioned in lines 1 and 2 above were in conformance with regulations and rules therefore as required in the current manual of survey instructions of the United States Department of the Interior, Bureau of Land Management or by a decree of a Court of Law and /or that the corner points mentioned in lines 3, 4 and 5 above were in conformance with the rules of the Michigan Board of Land Surveyors or by a Decree of a Court of Law; established, re-established, monumented, recovered, found as expressed below:

NOTE: Not more than 2 corners, all in the same town and range, may be recorded on this certificate.

	A	B	C	D	E	F	G	H	I	J	K	L	M
1													
2	6		5		4		3		2		1		
3													
4	7		8		9		10		11		12		
5													
6	13		17		16		15		14		13		
7													
8	19		20		21		22		23		24		
9													
10	30		29		28		27		26		25		
11													
12	31		32		33		34		35		36		
13													

A. Description of original monument and accessories and/or subsequent restoration:

I-10 1/4 Corner Common to Sections 26 & 27, Town 47 North, Range 1 West
1845 - Original ties (James Mullett): Sugar 10, N76°W 21 links - Sugar 8, N49°E 29 links.
1893 - County Surveyor notes from Carleton indicate a 3 foot long, 4" square cedar post, 1284 feet from 1/16 corner in Baker Side Road to the east.


B. Description of corner evidence found and/or method applied in restoring or reestablishing corner:

This corner is being re-established as part of the Chippewa County Remonumentation Program.
Re-established corner in the center of the remains of a fence post on an east-west fence line, 1282.8 feet from established 1/16 corner to the east (1284 feet per County Surveyor notes). Corner is 2634.24 feet from Section corner to the south, 2649.47 feet from Section corner to the north, and is 3.9 feet west of a straight line between said Section corners. North-south position also works fairly well with an old east-west fence line 1/4 mile to the north.

C. Description of monument for corner and accessories established to perpetuate locating the position of the corner:

Corner is a 3/4" x 24" rebar with a 3" aluminum Chippewa County Remonumentation cap on an old east-west fence line.
Witnesses:
11" Spruce, S67°W 23.60'
7" Spruce, S31°W 18.02'
8" Spruce, S08°W 10.21'
10" Red Pine, S51°E 28.77'

Note: Distances are to a nail/tag P.S. 33142 in the side of the tree. Trees are blazed and painted.
Bearings are compass bearings corrected for declination.

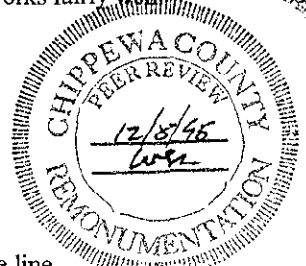

Signed by Keith R. Waters
Surveyor's Michigan License No. 33142

Date December 29, 1995