

CHIPPEWA COUNTY REMONUMENTATION CORNER

MAR 27 1996

LAND CORNER RECORDATION CERTIFICATE
Filing Requirement of Act 74, Mich. P.A. 1970

For corners in CHIPPEWA (County) Located In: _____ Corner Code # _____

1. Public Land Survey	T <u>47</u> N	R <u>1</u> W	<u>I-11</u>
	T _____	R _____	_____
	T _____	R _____	_____
	T _____	R _____	_____
2. Property Controlling in Section	S _____	T _____	R _____
	S _____	T _____	R _____
3. Miscellaneous Property in Sec.	S _____	T _____	R _____
	S _____	T _____	R _____

\$ 7.00 LAND CORNER
\$ 2.00 HSSR
28 FEB 96 4:43 P.M. RECEIPT# 459
RECEIVED FOR RECORD
CHIPPEWA COUNTY - STATE OF MICHIGAN
SHARON H. KENNEDY, REGISTER OF DEEDS

Register of Deeds Stamp & File Number

4. Lot No. _____, Recorded Plat _____
5. Private Claims _____

I, Keith R. Waters, in a field survey on 12/20, 1995 do hereby state that under requirements of P.A. 74, Michigan P.A. of 1970, the corner points mentioned in lines 1 and 2 above were in conformance with regulations and rules therefore as required in the current manual of survey instructions of the United States Department of the Interior, Bureau of Land Management or by a decree of a Court of Law and/or that the corner points mentioned in lines 3, 4 and 5 above were in conformance with the rules of the Michigan Board of Land Surveyors or by a Decree of a Court of Law; established, re-established, monumented, recovered, found as expressed below:

A	B	C	D	E	F	G	H	I	J	K	L	M
1												
2	6	5	4	3	2	1						
3												
4	7	8	9	10	11	12						
5												
6	18	17	16	15	14	13						
7												
8	19	20	21	22	23	24						
9												
10	30	29	28	27	26	25						
11												
12	31	32	33	34	35	36						
13												

NOTE: Not more than 2 corners, all in the same town and range, may be recorded on this certificate.

A. Description of original monument and accessories and/or subsequent restoration:
I-11 Corner Common to Sections 26, 27, 34, & 35, Town 47 North, Range 1 West
 1845 - Original ties (James Mullett): Hemlock 20, S60°E 32 links - Maple 12, N83°W 27 links.
 1925 - Chippewa County Surveyor notes. Small monument on top of stone and bolt.
 1990 - Larry R. Rogers, P.S. 29251, liber 7, page 397, Chippewa County recorded corners. Found PK nail prior to road re-construction.
 PK is on extension of a fence line to the south. Placed 1/2" iron at corner position after road construction. Witnesses:
 Power Pole (E8), N30°E 43.76' - Corner Fence Post, SOUTH 35.25' - 10" Aspen, S77°W 112.02' - Power Pole (E9), N76°W 161.02'


B. Description of corner evidence found and/or method applied in restoring or reestablishing corner:

This corner is being perpetuated as part of the Chippewa County Remonumentation Program.
 Found a 1/2" iron with plastic cap #29251 and all four witness objects as called for in LCRC recorded in liber 7, page 397
 Accepted corner as found.



C. Description of monument for corner and accessories established to perpetuate locating the position of the corner:

Corner is a 1/2" iron with a plastic cap #29251 approximately 0.5 feet south of the centerline of 5 Mile Road (asphalt), on the extension of a fence line to the south. Witnesses:
 Power Pole (E8), N30°E 43.76'
 Corner Fence Post, SOUTH 35.25'
 10" Aspen, S77°W 112.02'
 Power Pole (E9), N76°W 161.02'

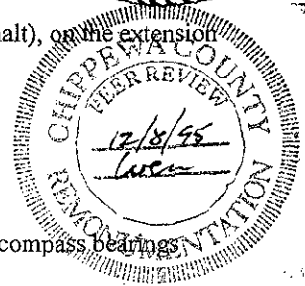

Note: Distances are to a nail/tag #29251 in the side of witness object. Aspen is blazed and painted. Bearings are compass bearings corrected for declination.

Signed by Keith R. Waters Date December 29, 1995
 Surveyor's Michigan License No. 33142