

MAR 27 1996 CHIPPEWA COUNTY REMONUMENTATION CORNER

COMMISSION

LAND CORNER RECORDATION CERTIFICATE
Filing Requirement of Act 74, Mich. P.A. 1970

For corners in

Chippewa

(County)

Located In:

Corner Code #

1. Public Land Survey

T47N R 1W

I-12

T R

T R

T R

2. Property Controlling
in Section

S T R

S T R

3. Miscellaneous
Property in Sec.

S T R

S T R

\$ 7.00 LAND CORNER

28 FEB 96 4:43 P.M.

RECEIPT# 459

RECEIVED FOR RECORD

CHIPPEWA COUNTY - STATE OF MICHIGAN

SHARON H. KENNEDY, REGISTER OF DEEDS

\$ 2.00 MSSR

Register of Deeds Stamp & File Number

4. Lot No. _____, Recorded Plat _____

5. Private Claims _____

I, Keith R. Waters, in a field survey on 12/09, 1995 do hereby state that under requirements of P.A. 74, Michigan P.A. of 1970, the corner points mentioned in lines 1 and 2 above were in conformance with regulations and rules therefore as required in the current manual of survey instructions of the United States Department of the Interior, Bureau of Land Management or by a decree of a Court of Law and /or that the corner points mentioned in lines 3, 4 and 5 above were in conformance with the rules of the Michigan Board of Land Surveyors or by a Decree of a Court of Law; established, re-established, monumented, recovered, found as expressed below:

NOTE: Not more than 2 corners, all in the same town and range, may be recorded on this certificate.

	A	B	C	D	E	F	G	H	I	J	K	L	M
1													
2		6		5		4		3		2		1	
3													
4		7		8		9		10		11		12	
5													
6		18		17		16		15		14		13	
7													
8		19		20		21		22		23		24	
9													
10		30		29		28		27		26		25	
11													
12		31		32		33		34	●	35		36	
13													


A. Description of original monument and accessories and/or subsequent restoration:

I-12 1/4 Corner Common to Sections 34 & 35, Town 47 North, Range 1 West
1845 - Original ties (James Mullett): Maple 4, N50°W 07 links - Fir 6, N30°E 25 links.

1974 - Corner is shown on a survey drawing by Neree D. Alix, R.L.S. 6254, as a set iron. Corner is shown at the intersection of fence lines north, south, east, and west.

B. Description of corner evidence found and/or method applied in restoring or reestablishing corner.

This corner is being perpetuated as part of the Chippewa County Remonumentation Program. Found a 5/8" rebar on a north-south fence line. Also found an existing blaze on a white birch facing the found rebar. 5/8" rebar is typical of type of monument used by Neree Alix. Corner is 2625.11 feet from Section corner to the south, 2641.12 feet from Section corner to the north, and is 0.68 feet east of a straight line between said Section corners. Accepted corner location as found and replaced 5/8" rebar with a 3/4" rebar and aluminum Chippewa County Remonumentation cap.

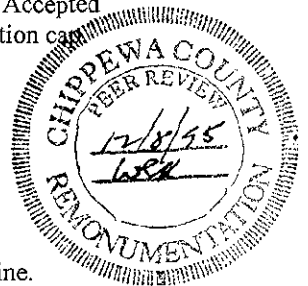

C. Description of monument for corner and accessories established to perpetuate locating the position of the corner:

Corner is a 3/4" x 24" rebar with a 3" aluminum Chippewa County Remonumentation cap on a north-south fence line.

Witnesses:

- 12" Spruce, S53°E 5.56'
- 8" Red Maple, NORTH 16.13'
- 8" Basswood, N81°W 21.78'
- 8" White Birch, N47°W 32.93' (Existing blaze)

Note: Distances are to a nail/tag P.S. 33142 in the side of the tree. Trees are blazed and painted. Bearings are compass bearings corrected for declination.



Signed by Keith R. Waters

Date December 29, 1995

Surveyor's Michigan License No. 33142