

1993

CHIPPEWA COUNTY REMONUMENTATION CORNER

RECEIVED FOR RECORD  
CHIPPEWA COUNTY  
STATE OF MICHIGAN

COMMISSION

LAND CORNER RECORDATION CERTIFICATE

93 DEC -3 PM 3: 56

Filing Requirement of Act 74, Mich. P.A. 1970

For corners in  
Chippewa

Located In: Corner Code #

*J. Roger Matlock*  
REGISTER OF DEEDS

1. Public Land Survey	T <u>47N</u> R <u>1W</u>	J-7
	T _____ R _____	_____
	T _____ R _____	_____
	T _____ R _____	_____
2. Property Controlling in Section	S _____ T _____ R _____	_____
	S _____ T _____ R _____	_____
3. Miscellaneous Property in Sec.	S _____ T _____ R _____	_____
	*S _____ T _____ R _____	_____

Register of Deeds Stamp & File Number

4. Lot No. \_\_\_\_\_, Recorded Plat \_\_\_\_\_  
5. Private Claims \_\_\_\_\_

I, Keith R. Waters in a field survey on July 29, 19 93, do hereby certify that under requirements of P.A. 74, Michigan P.A. of 1970, the corner points mentioned in lines 1 and 2 above were in conformance with regulations and rules therefore as required in the current manual of survey instructions of the United States Department of the Interior, Bureau of Land Management or by a decree of a Court of Law and/or that the corner points mentioned in lines 3, 4 and 5 above were in conformance with the rules of the Michigan Board of Land Surveyors or by a Decree of a Court of Law; established, re-established, monumented, re-monumented, recovered, found as expressed below:

NOTE: Not more than 4 corners, all in the same town and range, may be recorded on this certificate.

A. Description of original monument and accessories and/or subsequent restoration:

J-7 1/4 Corner Common to Sections 14 & 23, T47N, R1W.

This corner is recorded in liber 4, page 384, of Chippewa County corner records (1980), by William L. Karr, P.S. 27450, as 1/2" iron with cap #24599. Record witnesses: P. Pole, N04°E 44.28' 14" Pine, S55°W 23.03' 5" Maple, N57°W 78.35'

Corner is shown on a survey recorded in liber 2 of surveys, page 134, by Thomas M. Kelly, R.L.S. 24599 (1979), with the same ties as above.

B. Description of corner evidence found and/or method applied in restoring or reestablishing corner:

J-7 (T47N, R1W)

This corner is being perpetuated as part of the Chippewa County Remonumentation Program.

Found a 1/2" iron at the south edge of east-west asphalt road (3 Mile Road) as shown on survey recorded in liber 2 of surveys page 134. Corner has been used for several other surveys in the area in both Section 14 and Section 23. Power pole is lone remaining witness from previous recording. Accepted corner as found and established new witness objects.

Note: A 3/4" iron pin was found 10.82 feet north of this corner, in the centerline of 3 Mile Road.

C. Description of monument for corner and accessories established to perpetuate locating the position of the corner:


J-7 (T47N, R1W)

Corner is a 1/2" iron pin at the south edge of 3 Mile Road.

Witnesses:

- 22" Red Oak, N43°W 103.66'
- 12" Elm, S19°W 26.19'
- 7" Sugar Maple, S80°W 75.33'
- Nail w/cap 24599 in Power Pole (L-13-15), N07°E 44.63'
- 3/4" Iron Pin, NORTH 10.82'

Note: Unless noted otherwise distances are to a nail and tag in the side of witness object. Bearings are compass bearings corrected for declination. Trees are blazed and painted. Distances measured with EDM.

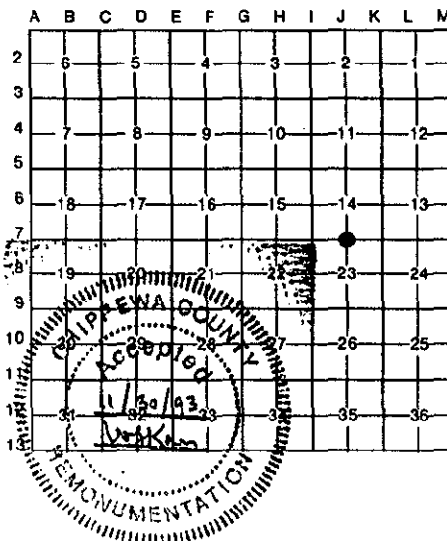

Signed by Keith R. Waters Date 11-30-93  
Surveyor's Michigan License No. 33142