

SECTION


LAND CORNER RECORDATION CERTIFICATE
Filing Requirement of Act 74, Mich. P.A. 1970
Chippewa County Remonumentation Corner

For corners in

Chippewa County Located in: Corner Code #
1. Public Land Survey T47N R1W K-4
2. Property Controlling in Section S T R
3. Miscellaneous Property in Sec. S T R
4. Lot No. , Recorded Plat
5. Private Claims

BOOK 11 PAGE 68

\$7.00 LAND CORNER
\$2.00 MSSR
23 FEB 2000 3:28:49 PM Receipt #21174
RECEIVED FOR RECORD
CHIPPEWA COUNTY - STATE OF MICHIGAN
SHARON H. KENNEDY, REGISTER OF DEEDS
Register of Deeds Stamp & File Number

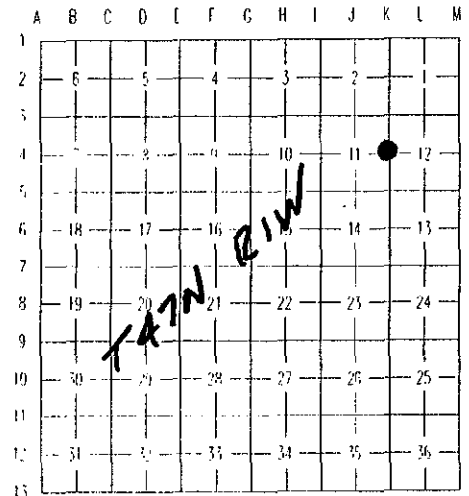

I, William L. Karr, in a field survey on September 7, 1999, do hereby state that under requirements of P.A. 74, Michigan P.A. of 1970, the corner points mentioned in lines 1 and 2 above were in conformance with regulations and rules therefore as required in the current manual of survey instructions of the United States Department of the Interior, Bureau of Land Management or by a decree of a Court of Law and /or that the corner points mentioned in lines 3, 4 and 5 above were in conformance with the rules of the Michigan Board of Land Surveyors or by a Decree of a Court of Law; established, re-established, monumented, recovered, found as expressed below:

NOTE: Not more than 2 corners, all in the same town and range, may be recorded on this certificate.

A. Description of original monument and accessories and/or subsequent restoration:
(K-4) 1/4 Corner Common to Sections 11 and 12, T. 47 N., R. 1 W.

- 1845 James H. Mullett set post in original survey.
1887 Guy H. Carleton surveyed Woodland Park Addition, L.1, P.42, Chippewa County Plats. The drawing shows the 1/4 corner but makes no mention of how it is monumented.
1901 F.H. Brown surveyed Plat of Foss and Hyde's 2nd Addition. The plat shows the corner as being monumented with 3/4" x 30" iron bolts.
1955 Bancroft W. Bufe recorded corner in L. 2, P. 119, Chippewa County Corner Records. Bufe recovered a 1" pipe 30' South and 30' East of the Southeast corner of Foss and Hyde's 2nd Addition, he also noted that the corner falls on the extension of an old fence to the East.
1977 James H. Granger, P.S. 16041, recorded corner in L. 1, P. 246, Chippewa County Corner Records. The corner record shows the corner as a 1" pipe, 12' East of the centerline of unimproved 12th street.
1981 William L. Karr, P.S. 27450, Reiss Coal Dock survey by Granger Engineering. Survey drawing shows the corner as recorded by Bufe and Granger.

B. Description of corner evidence found and/or method applied in restoring or reestablishing corner:
(K-4) 1/4 Corner Common to Sections 11 and 12, T. 47 N., R. 1 W.

This corner is being perpetuated as part of the Chippewa County Remonumentation Program.

Recovered a 1/2" iron with a Larry R. Rogers, P.S. 29251 cap at a location matching witnesses as recorded by Granger and Bufe, and shown on the Reiss Coal Dock Survey.
Accepted the corner position as found.

C. Description of monument for corner and accessories established to perpetuate locating the position of the corner:
(K-4) 1/4 Corner Common to Sections 11 and 12, T. 47 N., R. 1 W.

Corner is a 1/2" iron with a plastic cap stamped LRR / P.S. 29251. The corner falls 17.1' South of an East-West gravel road and 3.8' East of the centerline extended of a gravel road to the North.

Table with 4 columns: Witnesses, Bearing, Distance, and Status. Includes entries for Anchor Pole, Power Pole # 36, 1802, and 1718.

BOOK 11 PAGE 68

Bearings are compass bearings, corrected for declination (7° W), all distances are to a nail and tag in the side of the witness object unless otherwise noted.

Signed by [Signature]
Surveyor's Michigan License No. 27450

Date 12-29-99

