

1993

LAND CORNER RECORDATION CERTIFICATE
Filing Requirement of Act 74, Mich. P.A. 1970

93 DEC -3 PM 3:57

For corners in
Chippewa

	Located In:	Corner Code #
1. Public Land Survey	T <u>47N</u> R <u>1W</u>	<u>K-7</u>
	T _____ R _____	_____
	T _____ R _____	_____
	T _____ R _____	_____
2. Property Controlling in Section	S _____ T _____ R _____	_____
	S _____ T _____ R _____	_____
3. Miscellaneous Property in Sec.	S _____ T _____ R _____	_____
	S _____ T _____ R _____	_____
4. Lot No. _____, Recorded Plat _____		
5. Private Claims _____		


J. Roger Malotte
REGISTER OF DEEDS

Register of Deeds Stamp & File Number

I, Keith R. Waters, in a field survey on July 29, 19 93

do hereby certify that under requirements of P.A. 74, Michigan P.A. of 1970, the corner points mentioned in lines 1 and 2 above were in conformance with regulations and rules therefore as required in the current manual of survey instructions of the United States Department of the Interior, Bureau of Land Management or by a decree of a Court of Law and/or that the corner points mentioned in lines 3, 4 and 5 above were in conformance with the rules of the Michigan Board of Land Surveyors or by a Decree of a Court of Law; established, re-established, monumented, re-monumented, recovered, found as expressed below:

NOTE: Not more than 4 corners, all in the same town and range, may be recorded on this certificate.

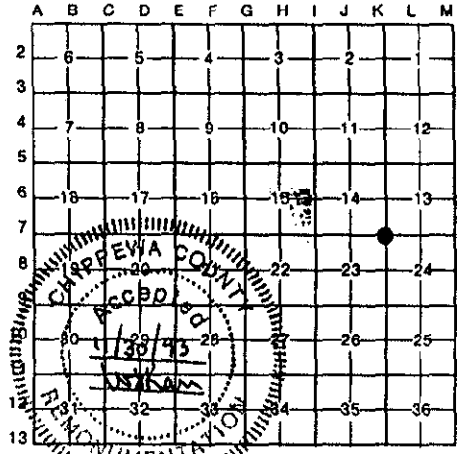

A. Description of original monument and accessories and/or subsequent restoration:

K-7 Section Corner Common to Sections 13, 14, 23, & 24, T47N, R1W.

This corner is recorded in liber 2, pages 228 & 245, by Michigan Department of State Highways (1960, 1973). Corner is also recorded in liber 1, page 263, by Max A. Connell, R.L.S. 17616 (1975), and in liber 1, page 263, by Thomas M. Kelly, R.L.S. 24599 (1977). Most recent recording by Kelly calls for a found steel bar on south edge of pavement, to be replaced with a monument box. Record witnesses: Twin 12" Oak, N19°E 126.26' MDSH&T tag in 9" Balsam, South MDSH&T tag in 6" Birch, S15°W 59.27' 55.25'

B. Description of corner evidence found and/or method applied in restoring or reestablishing corner:

K-7 (T47N, R1W)
This corner is being perpetuated as part of the Chippewa County Remonumentation Program. Found an iron with 1½" brass cap with chiseled "x" on top in a monument box in 3 Mile Road on west side of I-75 overpass. Distance to nail/tag in a dead balsam fir checks within 0.01' of Kelly records. Distance to 18" oak seems to check well (no measuring nail was found in oak). Accepted corner as found and established new witness objects.



C. Description of monument for corner and accessories established to perpetuate locating the position of the corner:

K-7 (T47N, R1W)
Corner is an iron with 1½" brass cap with chiseled "x" on top in a monument box in 3 Mile Road, west of I-75.
Witnesses:
18" Red Oak, N17°E 125.82'
Nail/tag in Top of Guard Rail Post (W'ly post, N side), N67°E 119.34'
9" White Birch, S17°W 59.18'
Power Pole, S29°W 55.77'
Dead Balsam Fir, SOUTH 55.24'

Note: Unless noted otherwise, distances are to a nail and tag in the side of witness object. Bearings are compass bearings corrected for declination. Trees are blazed and painted. Distances measured with EDM.

Signed by Keith R. Waters Date 11-30-93
Surveyor's Michigan License No. 33142