

MAR 27 1996

CHIPPEWA COUNTY REMONUMENTATION CORNER

LAND CORNER RECORDATION CERTIFICATE
Filing Requirement of Act 74, Mich. P.A. 1970

For corners in

Chippewa

(County)

Located In:

Corner Code #

1. Public Land Survey

T47N R 1W

K-9

T R

T R

T R

2. Property Controlling
in Section

S T R

S T R

3. Miscellaneous
Property in Sec.

S T R

S T R

\$ 7.00 LAND CORNER

\$ 2.00 MSSR

28 FEB 96 4:44 P.M.

RECEIPT# 459

RECEIVED FOR RECORD

CHIPPEWA COUNTY - STATE OF MICHIGAN
SHARON H. KENNEDY, REGISTER OF DEEDS

Register of Deeds Stamp & File Number

4. Lot No. _____, Recorded Plat _____

5. Private Claims _____

I, Keith R. Waters, in a field survey on 12/07, 1995 do hereby state that under requirements of P.A. 74, Michigan P.A. of 1970, the corner points mentioned in lines 1 and 2 above were in conformance with regulations and rules therefore as required in the current manual of survey instructions of the United States Department of the Interior, Bureau of Land Management or by a decree of a Court of Law and /or that the corner points mentioned in lines 3, 4 and 5 above were in conformance with the rules of the Michigan Board of Land Surveyors or by a Decree of a Court of Law; established, re-established, monumented, recovered, found as expressed below:

NOTE: Not more than 2 corners, all in the same town and range, may be recorded on this certificate.

	A	B	C	D	E	F	G	H	I	J	K	L	M
1													
2		6		5		4		3		2		1	
3													
4		7		8		9		10		11		12	
5													
6		18		17		16		15		14		13	
7													
8		19		20		21		22		23		24	
9													
10		30		29		28		27		26		25	
11													
12		31		32		33		34		35		36	
13													

A. Description of original monument and accessories and/or subsequent restoration:

K-9 Corner Common to Sections 23, 24, 25, & 26, Town 47 North, Range 1 West

1845 - Original corner established by James Mullett was a 20" Birch.

1944 - Rudolph Larsen, Chippewa County Surveyor notes, indicates a concrete monument for corner. Witnesses:

18" Pine Stump, N50°E 17.0' - 6" Balsam, S35°E 15' - 5" Cedar, WEST 4.5'

1955 - Bancroft Bufe, R.L.S. 6152, liber 2, page 123, Chippewa County recorded corners. Found bronze tablet 1' south of steel bar.

Witnesses: 6" Cedar, S85°W 4.6' - 9" Spruce, S40°W 15.4' - 5" Cedar, N45°E 6.8'

1960 - Michigan Department of State Highways, liber 3, page 235, Chippewa County recorded corners. Found concrete monument


with brass cap. Witnesses: 6" Cedar, N80°W 4.82' - 4" Balsam, N45°W 7.35' - 8" Balsam, S50°E 15.12

B. Description of corner evidence found and/or method applied in restoring or reestablishing corner:

This corner is being perpetuated as part of the Chippewa County Remonumentation Program.

Found a stamped 4" concrete "Chippewa County" monument 1 foot south of an iron pipe, which is on an old east-west fence line.

Also found the cedar bearing tree to the west as called for in 1944, 1955, and 1960 records. Accepted corner as found and established additional witness objects.

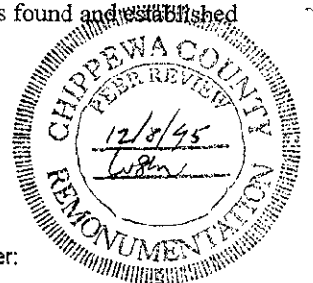

C. Description of monument for corner and accessories established to perpetuate locating the position of the corner:

Corner is a stamped 4" concrete "Chippewa County" monument 1 foot south of an iron pipe, which is on an east-west fence line.

Corner is approximately 110 feet west of westerly jog in the right-of-way fence on the west side of I-75. Witnesses:

10" Cedar, WEST 4.91'

5" Yellow Birch, S79°E 14.98'

15" White Pine, S10°E 33.04'

12" Red Maple, S36°W 14.32'



Note: Distances are to a nail/tag P.S. 33142 in the side of the tree. Trees are blazed and painted.

Bearings are compass bearings corrected for declination.

Signed by Keith R. Waters

Date December 29, 1995

Surveyor's Michigan License No. 33142