

**CHIPPEWA COUNTY REMONUMENTATION CORNER**

MAR 27 1996

**LAND CORNER RECORDATION CERTIFICATE**  
Filing Requirement of Act 74, Mich. P.A. 1970

For corners in

Chippewa

(County)

Located In:

Corner Code #

- |                                    |   |     |   |    |      |
|------------------------------------|---|-----|---|----|------|
| 1. Public Land Survey              | T | 47N | R | 1W | K-11 |
|                                    | T |     | R |    |      |
|                                    | T |     | R |    |      |
|                                    | T |     | R |    |      |
| 2. Property Controlling in Section | S |     | T | R  |      |
|                                    | S |     | T | R  |      |
| 3. Miscellaneous Property in Sec.  | S |     | T | R  |      |
|                                    | S |     | T | R  |      |

\$ 7.00 LAND CORNER  
\$ 2.00 MSSR  
28 FEB 96 4:45 P.M. RECEIPT# 459  
RECEIVED FOR RECORD  
CHIPPEWA COUNTY - STATE OF MICHIGAN  
SHARON H. KENNEDY, REGISTER OF DEEDS

Register of Deeds Stamp & File Number

4. Lot No. \_\_\_\_\_, Recorded Plat \_\_\_\_\_  
5. Private Claims \_\_\_\_\_

I, Keith R. Waters, in a field survey on 12/11, 1995 do hereby state that under requirements of P.A. 74, Michigan P.A. of 1970, the corner points mentioned in lines 1 and 2 above were in conformance with regulations and rules therefore as required in the current manual of survey instructions of the United States Department of the Interior, Bureau of Land Management or by a decree of a Court of Law and /or that the corner points mentioned in lines 3, 4 and 5 above were in conformance with the rules of the Michigan Board of Land Surveyors or by a Decree of a Court of Law; established, re-established, monumented, recovered, found as expressed below:

NOTE: Not more than 2 corners, all in the same town and range, may be recorded on this certificate.

	A	B	C	D	E	F	G	H	I	J	K	L	M
1													
2		6		5		4		3		2		1	
3													
4		7		8		9		10		11		12	
5													
6		18		17		16		15		14		13	
7													
8		19		20		21		22		23		24	
9													
10		30		29		28		27		26		25	
11													
12		31		32		33		34		35		36	
13													


**A. Description of original monument and accessories and/or subsequent restoration:**

K-11 Corner Common to Sections 25, 26, 35, & 36, Town 47 North, Range 1 West  
1845 - Original ties (James Mullett): Black Ash 10, S51°E 26 links - Birch 20, N42°W 43 links.

1960 - Michigan Department of State Highways, liber 3, page 235, Chippewa County recorded corners. Found squared wooden post in fence line. Witnesses: 4" Balsam, N10°W 26.70 - 14" Maple, S45°W 24.17 - 14" Birch, N60°W 24.92'

**B. Description of corner evidence found and/or method applied in restoring or reestablishing corner:**

This corner is being perpetuated as part of the Chippewa County Remonumentation Program.  
Found a bent iron pipe which checks well with two bearing trees with Highway Department tags as called for in liber 3, page 235.  
Replaced bent pipe with a 3/4" x 24" rebar and 3" aluminum Chippewa County Remonumentation cap and established new witness objects.

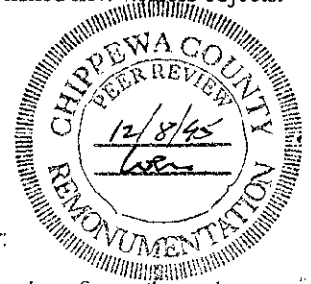

**C. Description of monument for corner and accessories established to perpetuate locating the position of the corner:**

Corner is a 3/4" x 24" rebar with a 3" aluminum Chippewa County Remonumentation cap. Corner is on the east edge of a north-south path, on the west side of the Charlotte River. Witnesses:  
16" White Birch, S58°E 32.60'  
9" Spruce, N66°E 28.22'  
24" Oak, S46°W 24.06'  
16" White Birch, N56°W 24.46'

Note: Distances are to a nail/tag P.S. 33142 in the side of the tree.  
Trees are blazed and painted. Bearings are compass bearings corrected for declination.



Signed by Keith R. Waters  
Surveyor's Michigan License No. 33142

Date December 29, 1995