

CHIPPEWA COUNTY REMONUMENTATION CORNER

MAR 27 1996

LAND CORNER RECORDATION CERTIFICATE
Filing Requirement of Act 74, Mich. P.A. 1970

For corners in
Chippewa

COMMISSION

Located In:

Corner Code #

- | | | | |
|------------------------------------|---------------|--------------|--------------|
| 1. Public Land Survey | T <u>47</u> N | R <u>1</u> W | K- <u>12</u> |
| | T | R | |
| | T | R | |
| | T | R | |
| 2. Property Controlling in Section | S | T | R |
| | S | T | R |
| 3. Miscellaneous Property in Sec. | S | T | R |
| | S | T | R |

\$ 7.00 LAND CORNER
\$ 2.00 MSSR
28 FEB 96 4:45 P.M. RECEIPT# 459
RECEIVED FOR RECORD
CHIPPEWA COUNTY - STATE OF MICHIGAN
SHARON H. KENNEDY, REGISTER OF DEEDS

Register of Deeds Stamp & File Number

4. Lot No. _____, Recorded Plat _____
5. Private Claims _____

I, Keith R. Waters, in a field survey on 12/11, 1995 do hereby state that under requirements of P.A. 74, Michigan P.A. of 1970, the corner points mentioned in lines 1 and 2 above were in conformance with regulations and rules therefore as required in the current manual of survey instructions of the United States Department of the Interior, Bureau of Land Management or by a decree of a Court of Law and /or that the corner points mentioned in lines 3, 4 and 5 above were in conformance with the rules of the Michigan Board of Land Surveyors or by a Decree of a Court of Law; established, re-established, monumented, recovered, found as expressed below:

NOTE: Not more than 2 corners, all in the same town and range, may be recorded on this certificate.

	A	B	C	D	E	F	G	H	I	J	K	L	M
1													
2		6		5		4		3		2		1	
3													
4		7		8		9		10		11		12	
5													
6		18		17		16		15		14		13	
7													
8		19		20		21		22		23		24	
9													
10		30		29		28		27		26		25	
11													
12		31		32		33		34		35		36	
13													


A. Description of original monument and accessories and/or subsequent restoration:

K-12 1/4 Corner Common to Sections 35 & 36, Town 47 North, Range 1 West
1845 - Original corner established by James Mullett was an 8" Fir.

Found no evidence of subsequent restoration of this corner.

B. Description of corner evidence found and/or method applied in restoring or reestablishing corner:

This corner is being re-established as part of the Chippewa County Remonumentation Program. Found no evidence of corner. Re-established corner on line between recovered Section corner K-11 to the north and Standard corner K-13 on the township line to the south. North-south location was determined from remains of a very old fence line to the west in Section 35. Distance north to K-11 is 2626.91 feet, distance south to K-13 is 2629.84 feet.

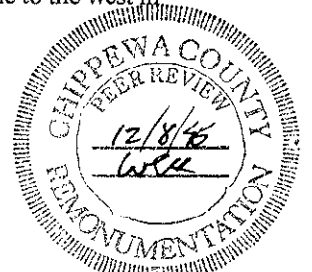

C. Description of monument for corner and accessories established to perpetuate locating the position of the corner:

Corner is a 3/4" x 24" rebar with a 3" aluminum Chippewa County Remonumentation cap. Corner is approximately 180 feet west of the centerline of Mackinac Trail. Witnesses:
10" Spruce, N52°W 42.81'
14" Spruce, N79°W 38.54'
8" White Birch, S21°W 43.47'
Power Pole, N81°E 89.54'

Note: Distances are to a nail and tag in the side of the witness object. Trees are blazed and painted. Bearings are compass bearings corrected for declination.



Signed by Keith R. Waters
Surveyor's Michigan License No. 33142

Date December 29, 1995