

1993

CHIPPEWA COUNTY REMONUMENTATION CORNER

RECEIVED FOR RECORD
CHIPPEWA COUNTY
STATE OF MICHIGAN

LAND CORNER RECORDATION CERTIFICATE

Filing Requirement of Act 74, Mich. P.A. 1970

93 DEC -3 PM 3: 57

COMMISSION

For corners in
Chippewa
(County)

	Located In:	Corner Code #
1. Public Land Survey	T 47N R 1W	L-7
	T _____ R _____	_____
	T _____ R _____	_____
	T _____ R _____	_____
2. Property Controlling in Section	S _____ T _____ R _____	_____
	S _____ T _____ R _____	_____
3. Miscellaneous Property in Sec.	S _____ T _____ R _____	_____
	S _____ T _____ R _____	_____

J. Roger Matlock
REGISTER OF DEEDS

Register of Deeds Stamp & File Number

4. Lot No. _____, Recorded Plat _____
5. Private Claims _____

	A	B	C	D	E	F	G	H	I	J	K	L	M
2	6		5		4		3		2		1		
3													
4	7		8		9		10		11		12		
5													
6	18		17		16		15		14		13		
7													
8	19		20		21		22		23		24		
9													
10	30		29		28		27		26		25		
11													
12	31		32		33		34		35		36		
13													

1. Keith R. Waters in a field survey on July 29, 19 93, do hereby certify that under requirements of P.A. 74, Michigan P.A. of 1970, the corner points mentioned in lines 1 and 2 above were in conformance with regulations and rules therefore as required in the current manual of survey instructions of the United States Department of the Interior, Bureau of Land Management or by a decree of a Court of Law and/or that the corner points mentioned in lines 3, 4 and 5 above were in conformance with the rules of the Michigan Board of Land Surveyors or by a Decree of a Court of Law; established, re-established, monumented, re-monumented, recovered, found as expressed below:

NOTE: Not more than 4 corners, all in the same town and range, may be recorded on this certificate.



A. Description of original monument and accessories and/or subsequent restoration:

L-7 1/4 Corner Common to Sections 13 & 24, T47N, R1W

This corner is recorded in liber 2, page 245 (1965, Highway Department, liber 1, page 78 (1973, Glenn Delamater), liber 1, page 204 (1976, James Granger), liber 1, page 263 (1977, Thomas Kelly), and liber 1, page 296 (1978, Thomas Kelly). Earliest recording (Highway Dept.) showed corner as a PK nail in 3 Mile Road. Later recordings show corner as 1/2" iron with cap 24599.

B. Description of corner evidence found and/or method applied in restoring or reestablishing corner:

L-7
This corner is being perpetuated as part of the Chippewa County Remonumentation Program. Found a 1/2" iron pin in a monument box approximately 24 feet south southerly curb line on I-75 Business Spur. Corner has been used in numerous surveys in the area. Distances to remaining witnesses from previous recordings check well. Some other witnesses as shown are missing or ambiguous. Accepted corner as found and established new witness objects

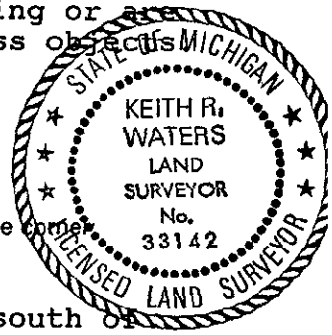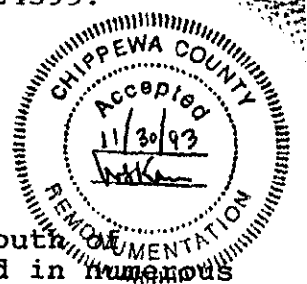

C. Description of monument for corner and accessories established to perpetuate locating the position of the corner:

L-7
Corner is a 1/2" iron pin in a monument box approximately 24' south of southerly curb on I-75 Business Spur, on east side of drive to Wendy's restaurant, at the intersection of 8th Street to the north. Witnesses:
Center of SE bolt on south end of
USA Mini-Mart sign, N18°W 166.23'
Nail/tag in Power Pole, N13°E 175.69'
Nail/tag in Power Pole (E-42), S09°W 54.00'
Corner of brick NW corner of Wendy's building, S39°W 130.78'
Nail/cap 24599 in P. Pole (E-41), S76°W 196.95'

Note: Bearings are compass bearings corrected for declination. Distances are measured with EDM.

Signed by Keith R. Waters Date 11-30-93

Surveyor's Michigan License No. 33142