

CHIPPEWA COUNTY REMONUMENTATION CORNER

MAR 27 1996

LAND CORNER RECORDATION CERTIFICATE

Filing Requirement of Act 74, Mich. P.A. 1970

For corners in

Chippewa

(County)

Located In:

Corner Code #

- | | | |
|------------------------------------|--|-------------|
| 1. Public Land Survey | T <u>47N</u> R <u>1W</u> | <u>L-11</u> |
| | T <u> </u> R <u> </u> | <u> </u> |
| | T <u> </u> R <u> </u> | <u> </u> |
| | T <u> </u> R <u> </u> | <u> </u> |
| 2. Property Controlling in Section | S <u> </u> T <u> </u> R <u> </u> | <u> </u> |
| | S <u> </u> T <u> </u> R <u> </u> | <u> </u> |
| 3. Miscellaneous Property in Sec. | S <u> </u> T <u> </u> R <u> </u> | <u> </u> |
| | S <u> </u> T <u> </u> R <u> </u> | <u> </u> |

\$ 7.00 LAND CORNER
 \$ 2.00 HSSR
 28 FEB 96 4:46 P.M. RECEIPT# 459
 RECEIVED FOR RECORD
 CHIPPEWA COUNTY - STATE OF MICHIGAN
 SHARON H. KENNEDY, REGISTER OF DEEDS

Register of Deeds Stamp & File Number

4. Lot No. _____, Recorded Plat _____
 5. Private Claims _____

I, Keith R. Waters, in a field survey on 12/12, 1995 do hereby state that under requirements of P.A. 74, Michigan P.A. of 1970, the corner points mentioned in lines 1 and 2 above were in conformance with regulations and rules therefore as required in the current manual of survey instructions of the United States Department of the Interior, Bureau of Land Management or by a decree of a Court of Law and /or that the corner points mentioned in lines 3, 4 and 5 above were in conformance with the rules of the Michigan Board of Land Surveyors or by a Decree of a Court of Law; established, re-established, monumented, recovered, found as expressed below:

NOTE: Not more than 2 corners, all in the same town and range, may be recorded on this certificate.

	A	B	C	D	E	F	G	H	I	J	K	L	M
1													
2	6		5		4		3		2		1		
3													
4	7		8		9		10		11		12		
5													
6	18		17		16		15		14		13		
7													
8	19		20		21		22		23		24		
9													
10	30		29		28		27		26		25		
11													
12	31		32		33		34		35		36		
13													

A. Description of original monument and accessories and/or subsequent restoration:

L-11 1/4 Corner Common to Sections 25 & 36, Town 47 North, Range 1 West
 1845 - Original corner established by James Mullett was a 4" Spruce.

Found no evidence of subsequent restoration of this corner.



B. Description of corner evidence found and/or method applied in restoring or reestablishing corner:


This corner is being re-established as part of the Chippewa County Remonumentation Program.
 Found no evidence of corner or its accessories. Re-established corner by single proportionate measurement between Section corners east and west. Corner falls on an east-west fence west line.

C. Description of monument for corner and accessories established to perpetuate locating the position of the corner:

Corner is a 3/4" x 24" rebar with a 3" aluminum Chippewa County Remonumentation cap on an east-west fence line.

- Witnesses:
- Wood Fence Post, EAST 1.79'
 - Wood Fence Post, WEST 11.32'
 - Wood Fence Post, EAST 12.79'
 - 9" Spruce, S86°E 254.66'

Note: Distances are to a nail/tag P.S. 33142 in the side of the witness object. Trees are blazed and painted.
 Bearings are compass bearings corrected for declination.

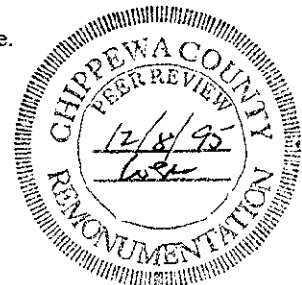

Signed by Keith R. Waters
 Surveyor's Michigan License No. 33142

Date December 29, 1995