

1993

CHIPPewa COUNTY REMONUMENTATION CORNER RECEIVED FOR RECORD  
CHIPPewa COUNTY  
STATE OF MICHIGAN

COMMISSION

LAND CORNER RECORDATION CERTIFICATE  
Filing Requirement of Act 74, Mich. P.A. 1970

93 DEC -3 PM 3:58

For corners in  
Chippewa


	Located In:	Corner Code #
1. Public Land Survey	T 47N R 1E T 47N R 1W	A-8 Same M-8 Corner
2. Property Controlling in Section	S ___ T ___ R ___	_____
3. Miscellaneous Property in Sec.	S ___ T ___ R ___ *S ___ T ___ R ___	_____

*J. Roger Malott*  
REGISTER OF DEEDS

Register of Deeds Stamp & File Number

4. Lot No. \_\_\_\_\_, Recorded Plat \_\_\_\_\_  
5. Private Claims \_\_\_\_\_

I, Keith R. Waters in a field survey on November 17, 1993, do hereby certify that under requirements of P.A. 74, Michigan P.A. of 1970, the corner points mentioned in lines 1 and 2 above were in conformance with regulations and rules therefore as required in the current manual of survey instructions of the United States Department of the Interior, Bureau of Land Management or by a decree of a Court of Law and/or that the corner points mentioned in lines 3, 4 and 5 above were in conformance with the rules of the Michigan Board of Land Surveyors or by a Decree of a Court of Law; established, re-established, monumented, re-monumented, recovered, found as expressed below:

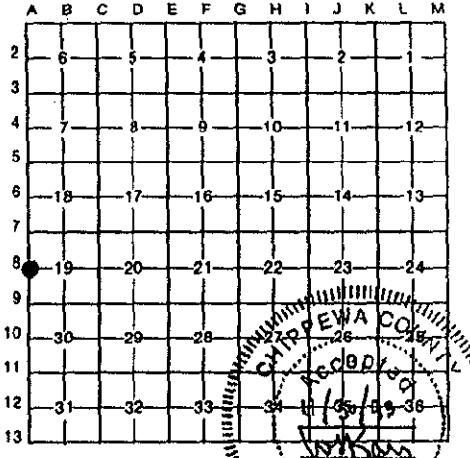

NOTE: Not more than 4 corners, all in the same town and range, may be recorded on this certificate.

A. Description of original monument and accessories and/or subsequent restoration:

A-8 (T47N, R1E)  
1/4 Corner Common to Section 19, T47N, R1E & Section 24, T47N, R1W.

This corner is recorded in liber 1, page 78, Chippewa County corner records, by Glenn F. DeLaMater, P.S. 13030 (1973), as original cedar Government monument with the following witnesses: 4" Scotch Pine, S70°W 39.61'  
3" Scotch Pine, S45°W 45.40'  
5" Scotch Pine, S20°W 55.40'



B. Description of corner evidence found and/or method applied in restoring or reestablishing corner:

A-8 (T47N, R1E)  
This corner is being perpetuated as part of the Chippewa County Remonumentation Program. Found remains of a squared wood post and a 1/2" rebar off the northeast corner of a stand of scotch pines, on the south side of a tag alder swamp to the north. Also found 4" and 3" scotch pine bearing trees from previous recording with measuring nails in sides dead but still standing. Distances from trees check with found 1/2" iron in wood post. Accepted corner position as found. Replaced 1/2" iron with a 3/4" rebar and 3 1/4" aluminum Chippewa County Remonumentation cap and established four new witness objects.

C. Description of monument for corner and accessories established to perpetuate locating the position of the corner:

A-8 (T47N, R1E)  
Corner is a 3/4" x 24" rebar with 3 1/4" Chippewa County Remonumentation cap in the center of a squared wood post. Witnesses:

- 9" Scotch Pine, S48°W 70.00'
- 10" Scotch Pine, S74°W 91.51'
- 3" Scotch Pine, S30°W 51.15'
- 5" Scotch Pine, S36°E 87.34'

Note: Distances are to a nail and tag in the side of witness object. Bearings are compass bearings corrected for declination. Trees are blazed and painted.

Signed by Keith R. Waters Date 11-30-93  
Surveyor's Michigan License No. 33142