

1993

CHIPPEWA COUNTY REMONUMENTATION CORNER
LAND CORNER RECORDATION CERTIFICATE
Filing Requirement of Act 74, Mich. P.A. 1970

RECEIVED FOR RECORD
CHIPPEWA COUNTY
STATE OF MICHIGAN

93 DEC -3 PM 3: 58

COMMISSION

For corners in
Chippewa
(County)


Located In: Corner Code #

- 1. Public Land Survey T 47N R 1E A-11 Same
T 47N R 1W M-11 Corner
- 2. Property Controlling S T R
- 3. Miscellaneous S T R
- Property in Sec. -S T R

J. Roger Malott
REGISTER OF DEEDS

Register of Deeds Stamp & File Number

- 4. Lot No. _____, Recorded Plat _____
- 5. Private Claims _____

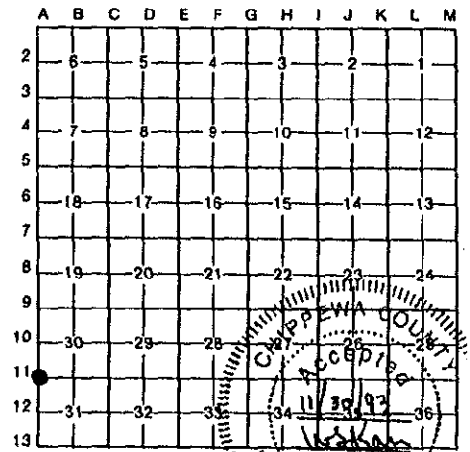

I, Keith R. Waters in a field survey on November 1, 19 93, do hereby certify that under requirements of P.A. 74, Michigan P.A. of 1970, the corner points mentioned in lines 1 and 2 above were in conformance with regulations and rules therefore as required in the current manual of survey instructions of the United States Department of the Interior, Bureau of Land Management or by a decree of a Court of Law and/or that the corner points mentioned in lines 3, 4 and 5 above were in conformance with the rules of the Michigan Board of Land Surveyors or by a Decree of a Court of Law; established, re-established, monumented, re-monumented, recovered, found as expressed below:

NOTE: Not more than 4 corners, all in the same town and range, may be recorded on this certificate.

A. Description of original monument and accessories and/or subsequent restoration:

A-11 (T47N, R1E)

Section Corner Common to Secs. 30 & 31, T47N, R1E & Secs. 25 & 36, T47N, R1W.

Original ties to set post (Wm. A. Burt, D.S., 1840):
Spruce 6, S70°W 11 links
Tamarack 8, N72°W 38 links

This corner is recorded in liber 2, page 196, by Rudolph H. Larsen as intersection of fence lines north, south, east, and west. No other information is shown.

B. Description of corner evidence found and/or method applied in restoring or reestablishing corner:

A-11 (T47N, R1E)

This corner is being re-established as part of the Chippewa County Remonumentation Program.

Found no evidence of corner or its accessories. Re-established corner by single proportionate measurement between established corners at the West 1/4 corner of Section 31, T47N, R1E, and the Northwest corner of Section 30, T47N, R1E. 

C. Description of monument for corner and accessories established to perpetuate locating the position of the corner:


A-11 (T47N, R1E)

Corner is a 3/4" x 48" rebar with a 3/4" aluminum Chippewa County Remonumentation cap in the centerline of a north-south ditch line.

Witnesses:

- Nail/tag in wood fence post, N03°E 50.04'
- Center of set metal fence post, NORTH 1.7'
- West 1/4 Corner Section 31, SOUTH 2638.28'
- North 1/4 Corner Section 31, EAST 2653.80'

Note: Corner falls in a tag alder swamp, no other ties are available. Bearings are compass bearing corrected for declination.

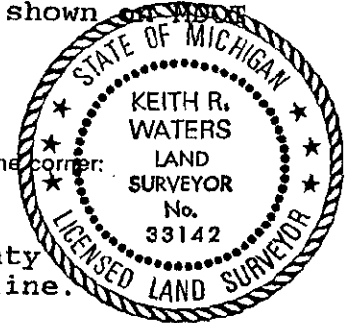

Signed by Keith R. Waters Date 11-30-93
Surveyor's Michigan License No. 33142