

JAN 18 2001

LAND CORNER RECORDATION CERTIFICATE  
Filing Requirement of Act 74, Mich. P.A. 1970

For corners in  
Chippewa  
(County)

Located In:

Corner Code #

- 1. Public Land Survey
 

T	<u>46N</u>	R	<u>1E</u>	<u>A-1</u>	
T	<u>47N</u>	R	<u>1E</u>	<u>A-13</u>	Same
T	<u>46N</u>	R	<u>1W</u>	<u>M-1</u>	Corner
T	<u>47N</u>	R	<u>1W</u>	<u>M-13</u>	
- 2. Property Controlling in Section
 

S	___	T	___	R	___
S	___	T	___	R	___
- 3. Miscellaneous Property in Sec.
 

S	___	T	___	R	___
S	___	T	___	R	___
- 4. Lot No. \_\_\_\_\_, Recorded Plat \_\_\_\_\_
- 5. Private Claims \_\_\_\_\_

RECEIVED FOR RECORD  
CHIPPEWA COUNTY  
STATE OF MICHIGAN


94 JUL 22 AM 11:17

*J. Roger Malott*

REGISTER OF DEEDS

Register of Deeds Stamp & File Number

I, William L. Karr, in a field survey on NOVEMBER 3, 19 93, do hereby certify that under requirements of P.A. 74, Michigan P.A. of 1970, the corner points mentioned in lines 1 and 2 above were in conformance with regulations and rules therefore as required in the current manual of survey instructions of the United States Department of the Interior, Bureau of Land Management or by a decree of a Court of Law and/or that the corner points mentioned in lines 3, 4 and 5 above were in conformance with the rules of the Michigan Board of Land Surveyors or by a Decree of a Court of Law; established, re-established, monumented, re-monumented, recovered, found as expressed below:

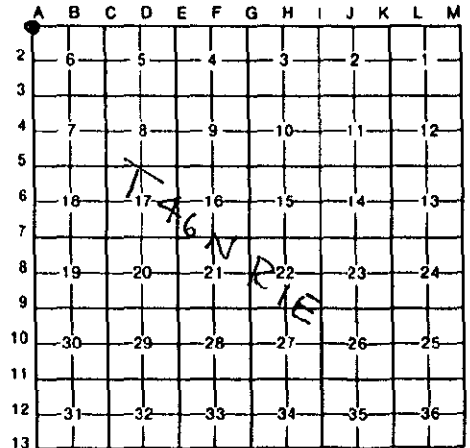

NOTE: Not more than 4 corners, all in the same town and range, may be recorded on this certificate.

A. Description of original monument and accessories and/or subsequent restoration:  
(A-1) Northwest Corner of Section 6 (Township Corner) T46N-R1E

1840: Corner established by Wm. A. Burt

1991: W.L. Karr found 1 1/2" O.D. pipe and accepted (Liber 7, Page 319).

- "V" Notch in C.M.P. N06°E 36.71'
- "V" Notch in C.M.P. S06°E 39.85'
- Power Pole DR3/111/10 N66°W 68.11'

B. Description of corner evidence found and/or method applied in restoring or reestablishing corner:

(A-1) Found corner and accessories as recorded in Liber 7, Page 319 of the Chippewa County Records. Accepted corner position as found.

C. Description of monument for corner and accessories established to perpetuate locating the position of the corner:

(A-1) Corner is a 1 1/2" O.D. pipe. Falls approximately 1' North of centerline of 6 Mile Road. Falls on extension of fence lines to the North and South.

Witnesses:

- "V" Notch in C.M.P. N06°E 36.71'
- "V" Notch in C.M.P. S06°E 39.85'
- Power Pole DR3/111/10 N66°W 68.11'

- No other witnesses available -



Signed by William L. Karr Surveyor's Michigan License No. 27450

Date 7/21/94

855-00

FORM APPROVED BY MICHIGAN STATE BOARD OF LAND SURVEYORS, JAN. 28, 1971

REVISIED MAY 14, 1975

REVISIED JAN., 1983

NOTE: Bearings are compass bearings corrected for declination.

Distances are to a nail in side of witness objects unless noted.

LIBER 8 PAGE 335