

CHIPPewa COUNTY
REMONUMENTATION

NOV 13 1999

LAND CORNER RECORDATION CERTIFICATE
 Filing Requirement of Act 74, Mich. P.A. 1970
 Chippewa County Remonumentation Corner

For corners in SECTION

Chippewa Located In: Corner Code #

1. Public Land Survey SAME CORNER { T 47N R 1E
 T 47N R 2E } M-2
 T R A-2 ✓

2. Property Controlling in Section S T R
 S T R
 S T R

3. Miscellaneous Property in Sec. S T R
 S T R


\$7.00 LAND CORNER
 \$2.00 HSSR
 21 JAN 1999 11:03:56 AM Receipt #1312
 RECEIVED FOR RECORD
 CHIPPewa COUNTY - STATE OF MICHIGAN
 SHARON H. KENNEDY, REGISTER OF DEEDS

BOOK 10 PAGE 368
 Register of Deeds Stamp & File Number

4. Lot No. _____ Recorded Plat _____
 5. Private Claims _____

I, Larry R. Rogers, in a field survey on November 11, 1998, do hereby state that under requirements of P.A. 74, Michigan P.A. of 1970, the corner points mentioned in lines 1 and 2 above were in conformance with regulations and rules therefore as required in the current manual of survey instructions of the United States Department of the Interior, Bureau of Land Management or by a decree of a Court of Law and/or that the corner points mentioned in lines 3, 4 and 5 above were in conformance with the rules of the Michigan Board of Land Surveyors or by a Decree of a Court of Law; established, re-established, monumented, recovered, found as expressed below:

NOTE: Not more than 2 corners, all in the same town and range, may be recorded on this certificate.

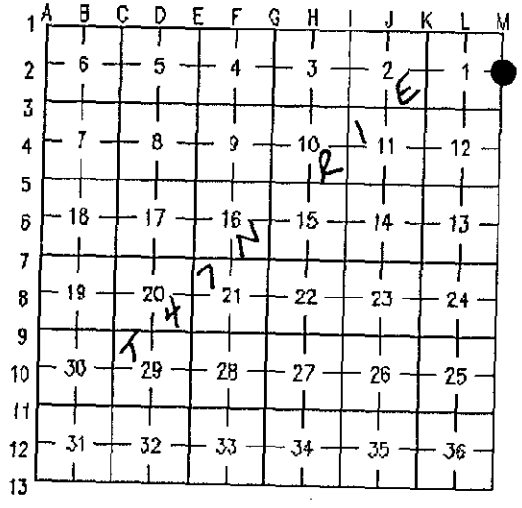


A. Description of original monument and accessories and/or subsequent restoration:
 (M-2) East 1/4 corner of Section 1, Township 47 North, Range 1 East.
 The original corner was placed in 1845 by John Mullett. Found no reference to corner in County Surveyor notes. In 1981, Granger Engineering showed the computed position of this corner to be midway and on-line between the Northeast and Southeast corners of Section 1, but no corner was set. The original G.L.O. notes call for 80.00 chains along the East line of Section 1.

B. Description of corner evidence found and/or method applied in restoring or reestablishing corner:
 (M-2) East 1/4 corner of Section 1, Township 47 North, Range 1 East.
 This corner is being perpetuated as part of the Chippewa County Remonumentation Program. Found no evidence of original corner position. Re-established corner position midway and on-line between the Northeast and Southeast corners of Section 1. Found old steel fence post 20 feet to Northwest of set corner. Unable to verify origin of fence post. Distances to corners North and South are 2634.58 feet.

C. Description of monument for corner and accessories established to perpetuate locating the position of the corner:
 (M-2) East 1/4 corner of Section 1, Township 47 North, Range 1 East.
 Corner is a 3/4" x 24" re-rod with stamped aluminum cap set in low, wet area Southwesterly of old field.

Witnesses:

16" Spruce	N11°E	50.56 feet
8" Ironwood	N40°W	15.02 feet
Steel Fence Post	N47°W	19.67 feet
12" Ash	S78°W	5.56 feet
6" Ash	S79°E	26.45 feet
New Steel Fence Post	North	2.0 feet

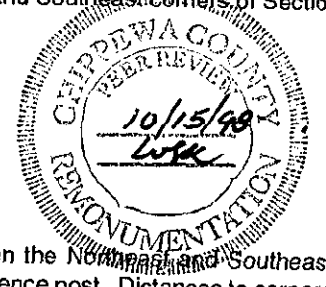

Signed by [Signature]

Date 30 DEC 1998

Surveyor's Michigan License No. 29251

NOTE: All bearings are compass bearings corrected for declination (6°W). All distances are to a nail and tag in the side of witness object unless otherwise noted.