

JAN 19 1999

LAND CORNER RECORDATION CERTIFICATE
 Filing Requirement of Act 74, Mich. P.A. 1970
 Chippewa County Remonumentation Corner

For corners in SECTION

<u>Chippewa</u>	Located In:	Corner Code #
1. Public Land Survey	SAME	M-4
CORNER	{ T 47N R 1E	A-4 ✓
	{ T 47N R 2E	
	T _____ R _____	
	T _____ R _____	
2. Property Controlling in Section	S _____ T _____ R _____	
	S _____ T _____ R _____	
3. Miscellaneous Property in Sec.	S _____ T _____ R _____	
	S _____ T _____ R _____	

\$7.00 LAND CORNER
 \$2.00 MSSR
 21 JAN 1999 11:05:27 AM Receipt #1312
 RECEIVED FOR RECORD
 CHIPPEWA COUNTY - STATE OF MICHIGAN
 SHARON H. KENNEDY, REGISTER OF DEEDS

Register of Deeds, Stamp & File Number

4. Lot No. _____, Recorded Plat _____
 5. Private Claims _____


I, Larry R. Rogers, in a field survey on November 09, 1998, do hereby state that under requirements of P.A. 74, Michigan P.A. of 1970, the corner points mentioned in lines 1 and 2 above were in conformance with regulations and rules therefore as required in the current manual of survey instructions of the United States Department of the Interior, Bureau of Land Management or by a decree of a Court of Law and/or that the corner points mentioned in lines 3, 4 and 5 above were in conformance with the rules of the Michigan Board of Land Surveyors or by a Decree of a Court of Law; established, re-established, monumented, recovered, found as expressed below:

NOTE: Not more than 2 corners, all in the same town and range, may be recorded on this certificate.

1	A	B	C	D	E	F	G	H	I	J	K	L	M
2		6		5		4		3		2		1	
3													
4		7		8		9		10		11		12	
5													
6		18		17		16		15		14		13	
7													
8		19		20		21		22		23		24	
9													
10		30		29		28		27		26		25	
11													
12		31		32		33		34		35		36	
13													

A. Description of original monument and accessories and/or subsequent restoration:
 (M-4) East 1/4 Corner of Section 12, Township 47 North, Range 1 East.
 The original corner was placed in 1845 by John Mullett. County Surveyor records give no specific information about corner. In 1982, William L. Karr, P.S. 27450, found and accepted a 1/2" iron pipe on South shoulder of East-West County Road and filed a L.C.R.C. in Liber 6, Page 116 of the Chippewa County Corner Records. Corner has since been destroyed by the Chippewa County Road Commission.

B. Description of corner evidence found and/or method applied in restoring or reestablishing corner:
 (M-4) East 1/4 Corner of Section 12, Township 47 North, Range 1 East.
 This corner is being perpetuated as part of the Chippewa County Remonumentation Program. Recovered several Karr witnesses from 1982 recording and re-established 1/4 Corner from the witnesses.

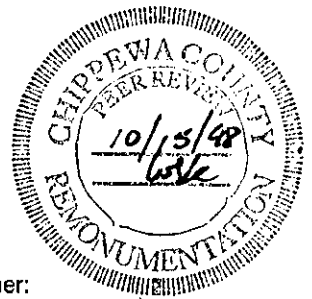

C. Description of monument for corner and accessories established to perpetuate locating the position of the corner:
 (M-4) East 1/4 Corner of Section 12, Township 47 North, Range 1 East.
 Corner is a 3/4" x 24" re-rod with plastic remonumentation cap 8 feet South of the centerline of 1 1/2 Mile Road (East-West, paved).

Witnesses:

Concrete Monument with 27450 cap	South	33.00 feet
10" Ash	S15°E	45.79 feet
12" Ash	N17°E	64.64 feet
4" Oak	N36°W	47.85 feet
8" Ash	S14°W	43.12 feet

Signed by [Signature] Date 30 DEC 1998

Surveyor's Michigan License No. 29251
 NOTE: All bearings are compass bearings corrected for declination (6°W). All distances are to a nail and tag in the side of witness object unless otherwise noted.

wp:wpdocs\larry\corner\47n1e.m4

